


DATE Nov. 7, 1980

TOWN OF LEXINGTON — BOARD OF PUBLIC WORKS

SEWER DIVISION

Sketch of Service Here **47**

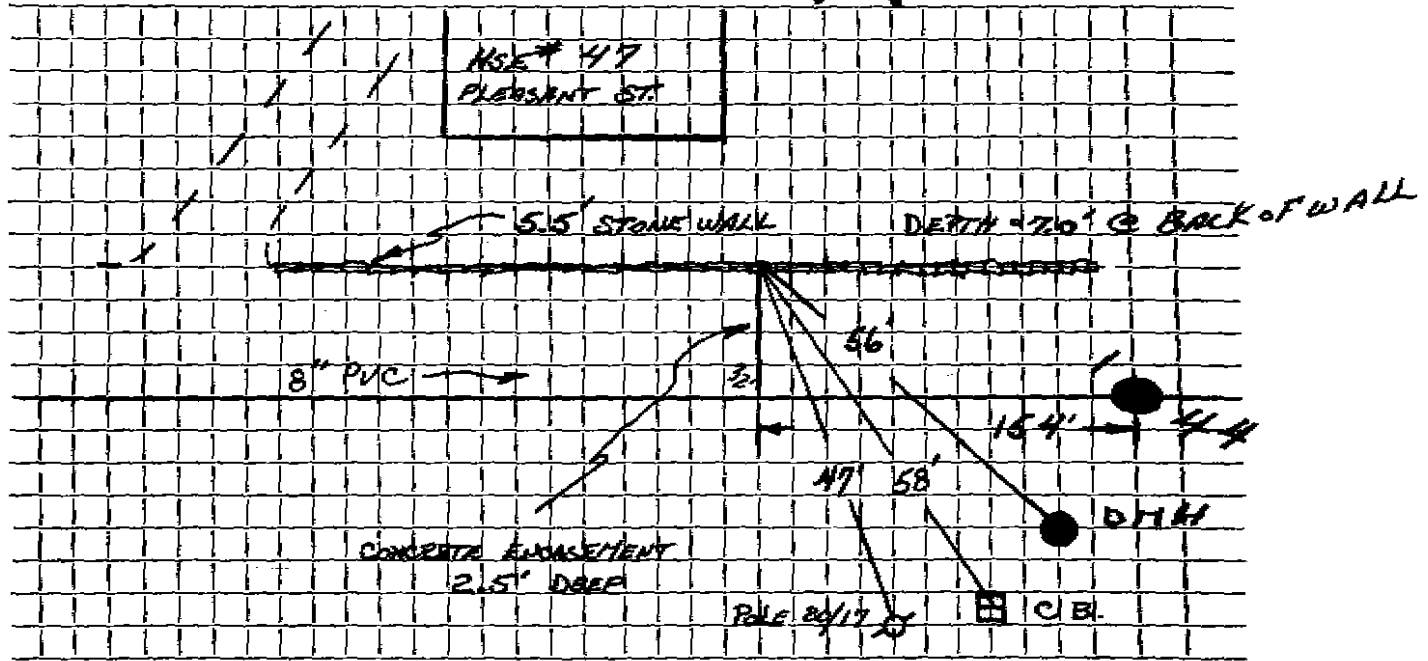

Connection made in PLEASANT Street. Work completed NOV. 7, 1980

Remarks:

.....

.....