


DATE OCT. 31, 1980

TOWN OF LEXINGTON — BOARD OF PUBLIC WORKS
SEWER DIVISION

Sketch of Service Here

48

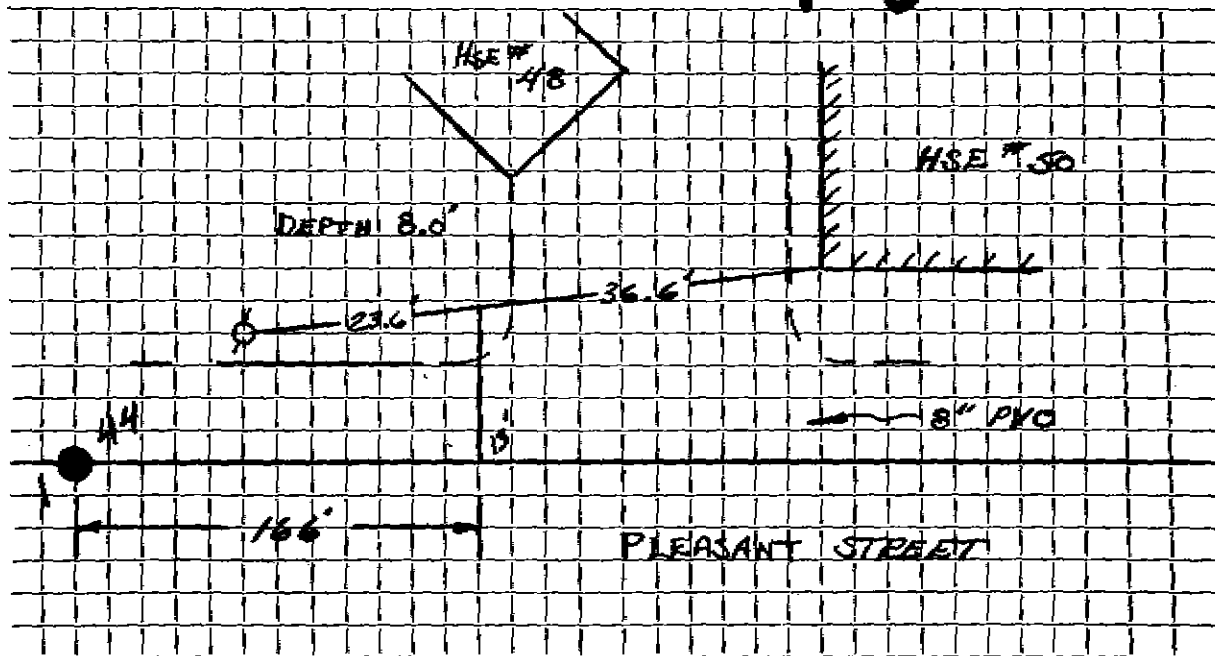

Connection made in PLEASANT Street. Work completed OCT. 31, 1980

Remarks:


.....

.....

DATE Dec 30 1997

TOWN OF LEXINGTON — BOARD OF PUBLIC WORKS
SEWER DIVISION

Sketch of Service Here

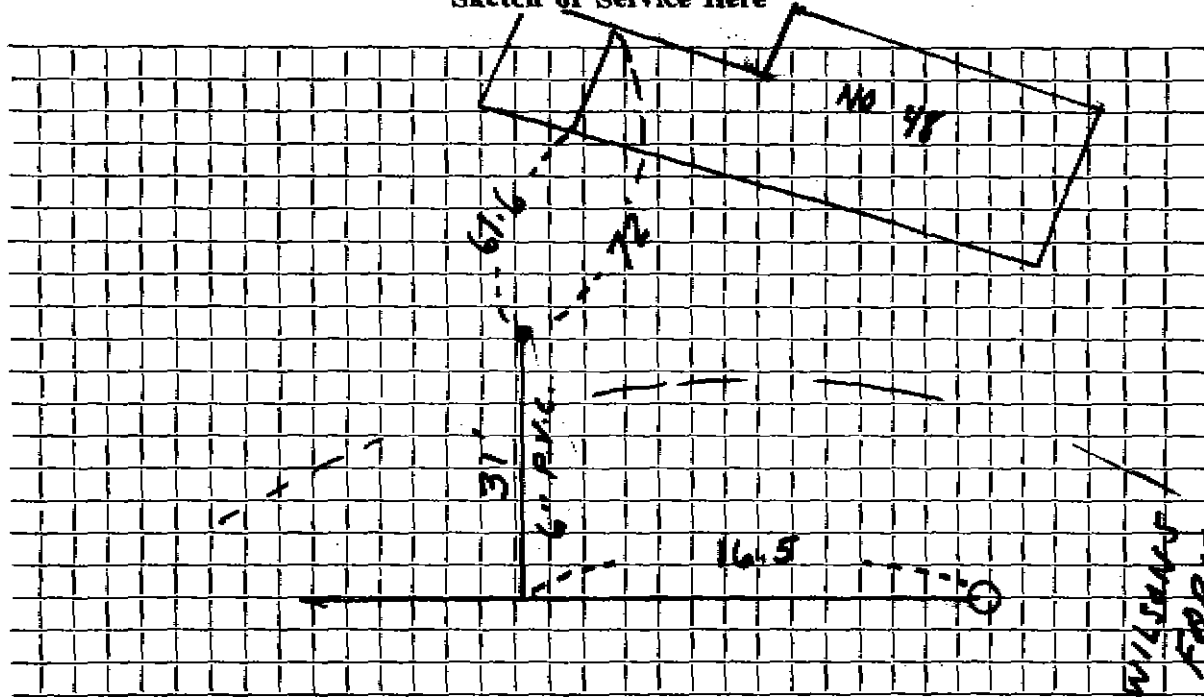

Connection made in EASMENT Street. Work completed J.M. MCLAUGHLIN

Remarks:

..... FIELD BOOK 97-5 TJM