


DATE 10-19-94

TOWN OF LEXINGTON — BOARD OF PUBLIC WORKS

SEWER DIVISION

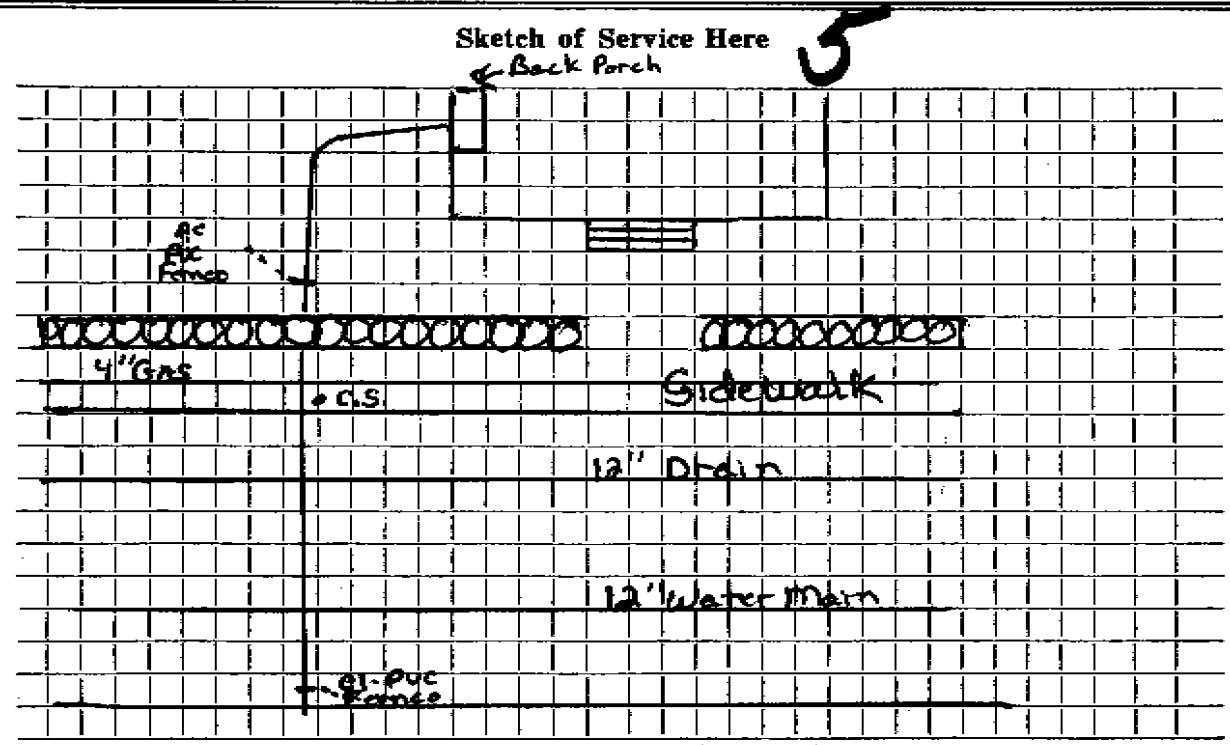

Connection made in Street. Work completed 10/19/94

Remarks: 26'-6" PVC From 3' Inside Wall to Sewer main

2'-6" PVC-PVC Fernco In Sidewalk

Water Service... Runs right beside Sewer Service & right side