




DATE 12-8-82

TOWN OF LEXINGTON — BOARD OF PUBLIC WORKS  
SEWER DIVISION

Sketch of Service Here **50**

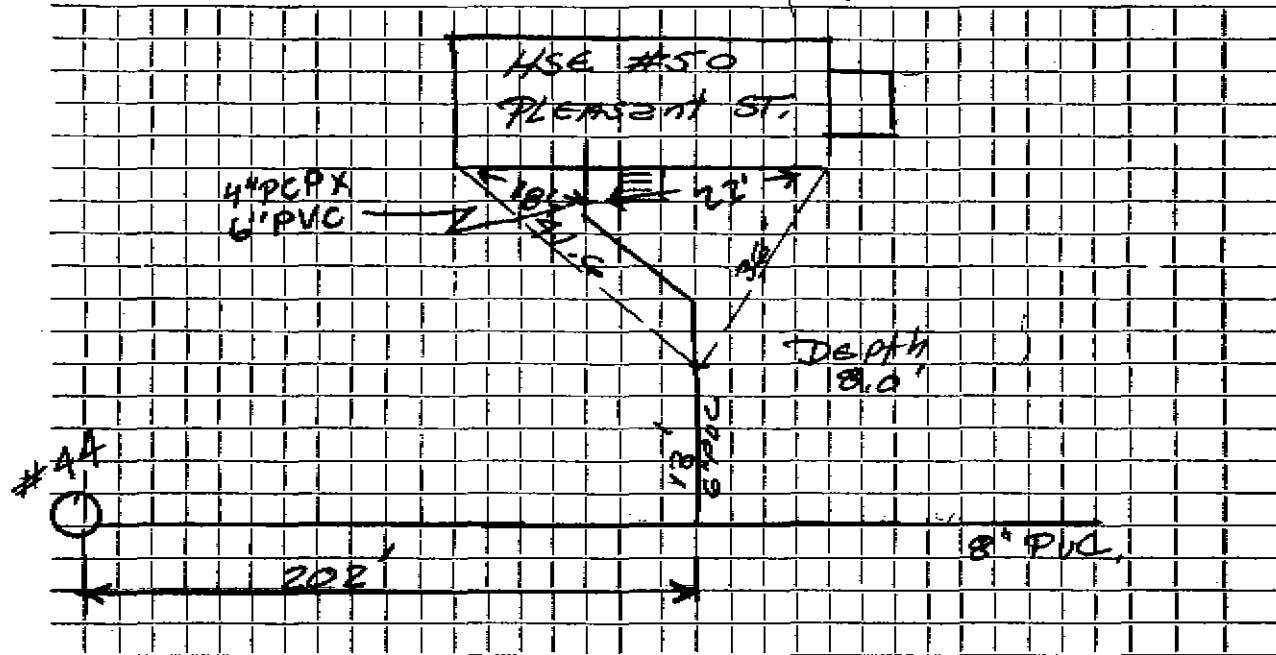

Connection made in PLEASANT Street. Work completed OCT 31, 1980

Remarks: 4\"/>.....

.....

.....