


DATE Nov. 4, 1980

TOWN OF LEXINGTON — BOARD OF PUBLIC WORKS

SEWER DIVISION

Sketch of Service Here **52**

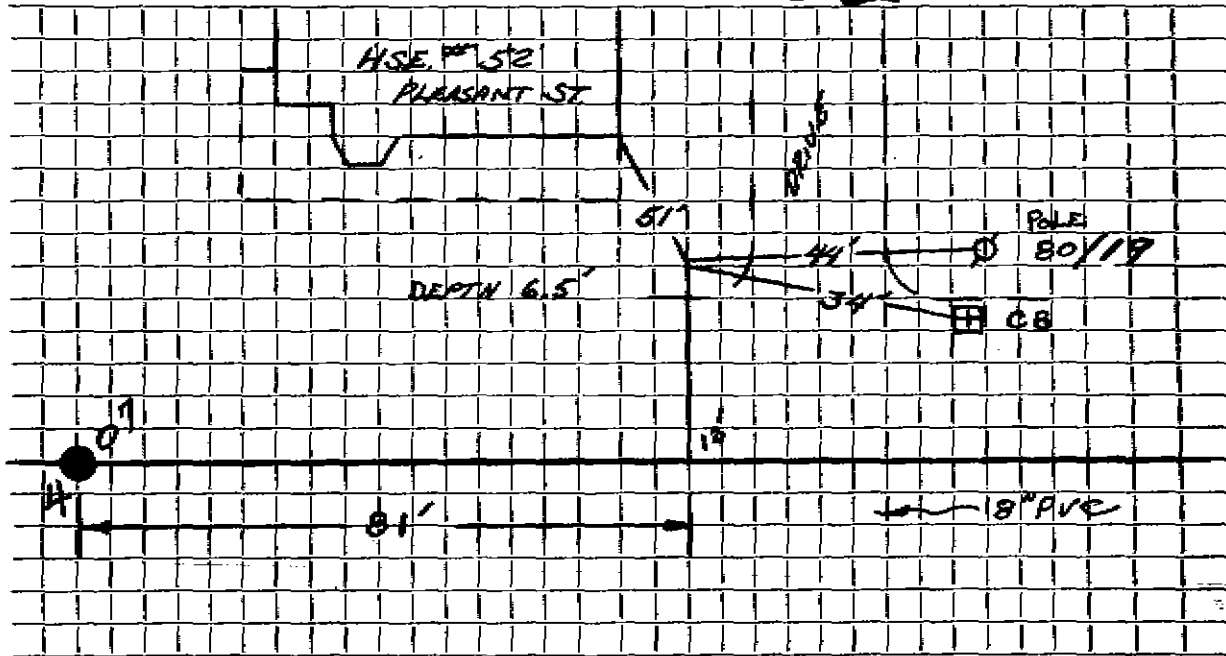

Connection made in PLEASANT Street. Work completed Nov. 4, 1980

Remarks:

.....

.....

Name Wilson Farms Service No. _____

Address ~~29 Mason Street~~ 52 Pleasant Street

Location _____

Kind of Pipe _____

Size _____

Size of Main _____

Repair—Renewal—New Service

Dave Eagle #1539


Location _____

Date		Material	Amount	Total	Date	Amount
-70	153'	6" Transite pipe				
	33'	6" Clay				

DATE _____

TOWN OF LEXINGTON — BOARD OF PUBLIC WORKS

SEWER DIVISION

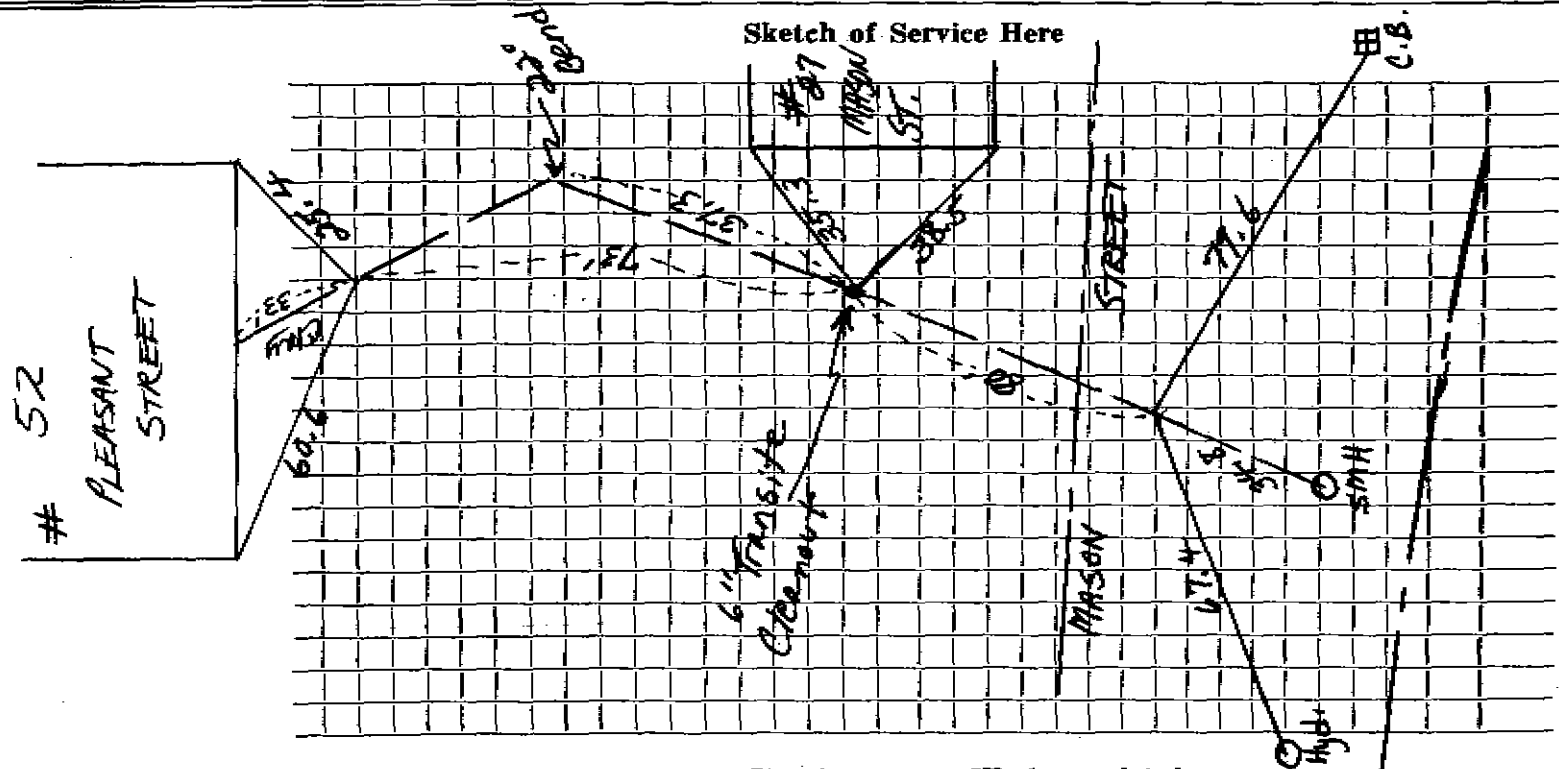

Connection made in Street. Work completed

Remarks:
.....
.....