


DATE Nov. 5, 1980

TOWN OF LEXINGTON — BOARD OF PUBLIC WORKS
SEWER DIVISION

Sketch of Service Here

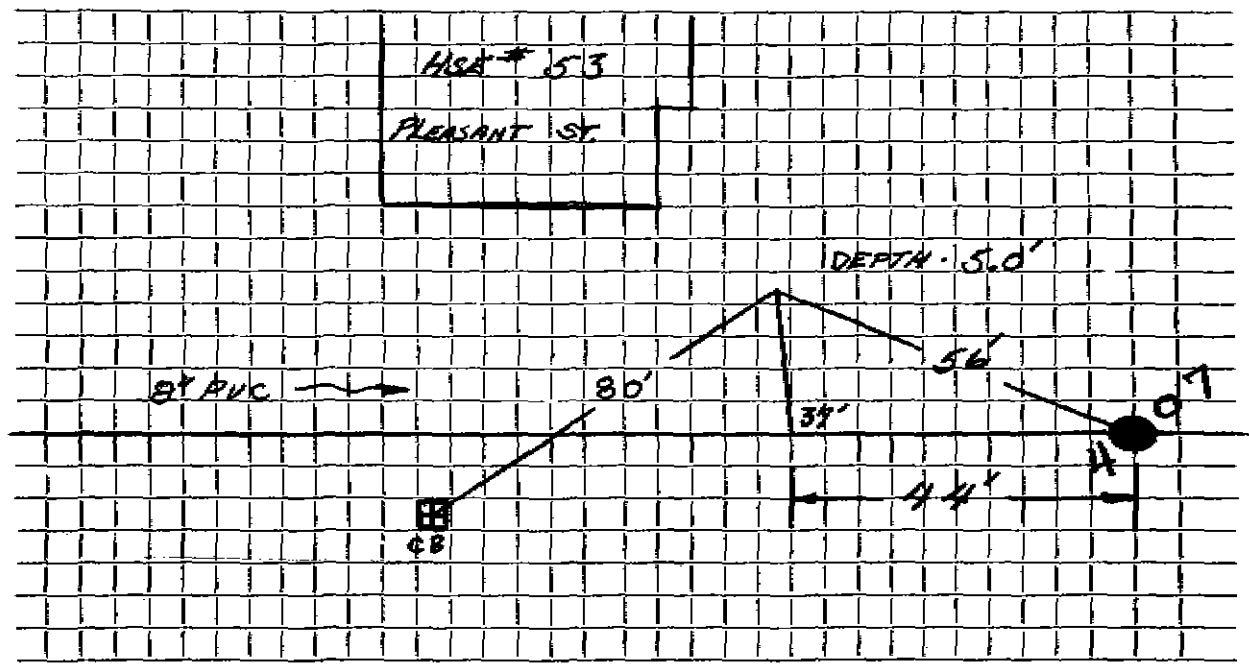

Connection made in PLEASANT Street. Work completed Nov. 5, 1980

Remarks:

.....

.....