

Name **Grant J. Wayne**
Bruce Kozich

Service No. 19

Address ~~55 MILLIKEN ROAD~~ 55 PLEASANT ST.

Location

Kind of Pipe **PVC**

Size **6"**

Size of Main **8"**

Repair—Renewal—New Service **Valeri #3938**
NEW SERVICE

Location **FEB 19 1985**


Date		Material	Amount	Total	Date	Amount
Nov. 12, 1980		17' of 6" PVC	14 00	238 00	7/16/82	238 00
12/2/84	37'	x 6" P.V.C.				
	1	6" x 45° Bend				
	1	6" x 4" Donut				

Deposit

DATE Nov. 12, 1980

TOWN OF LEXINGTON — BOARD OF PUBLIC WORKS
SEWER DIVISION

Sketch of Service Here **55**

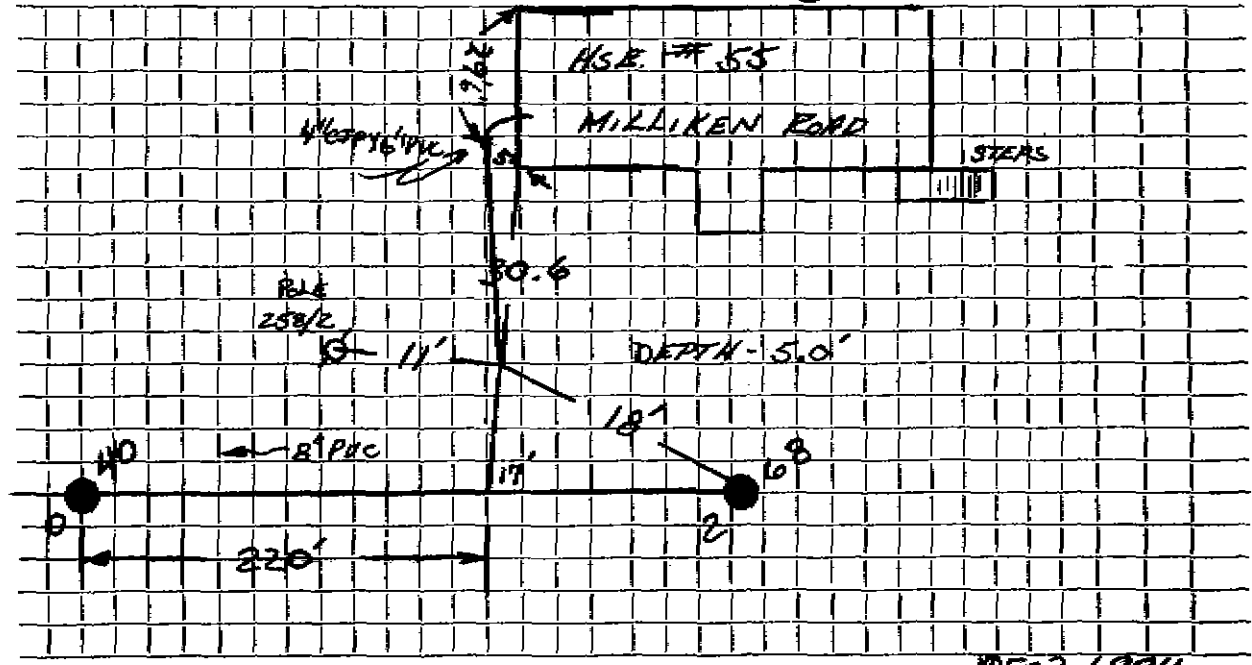

Connection made in .. MILLIKEN .. Street.

Work completed .. DEC 3, 1984 ..
NOV. 12, 1980

Remarks: ..
.....
.....