

Name

Service No.

Address

57 PLEASANT ST.

Location

Kind of Pipe

Size

Size of Main

Repair—Renewal—New Service

J. M. Lucente # 2372

Location


Date	Material	Amount	Total	Date	Amount
14-73	155' - 6" ACP				

DATE _____

TOWN OF LEXINGTON — BOARD OF PUBLIC WORKS

SEWER DIVISION

Sketch of Service Here

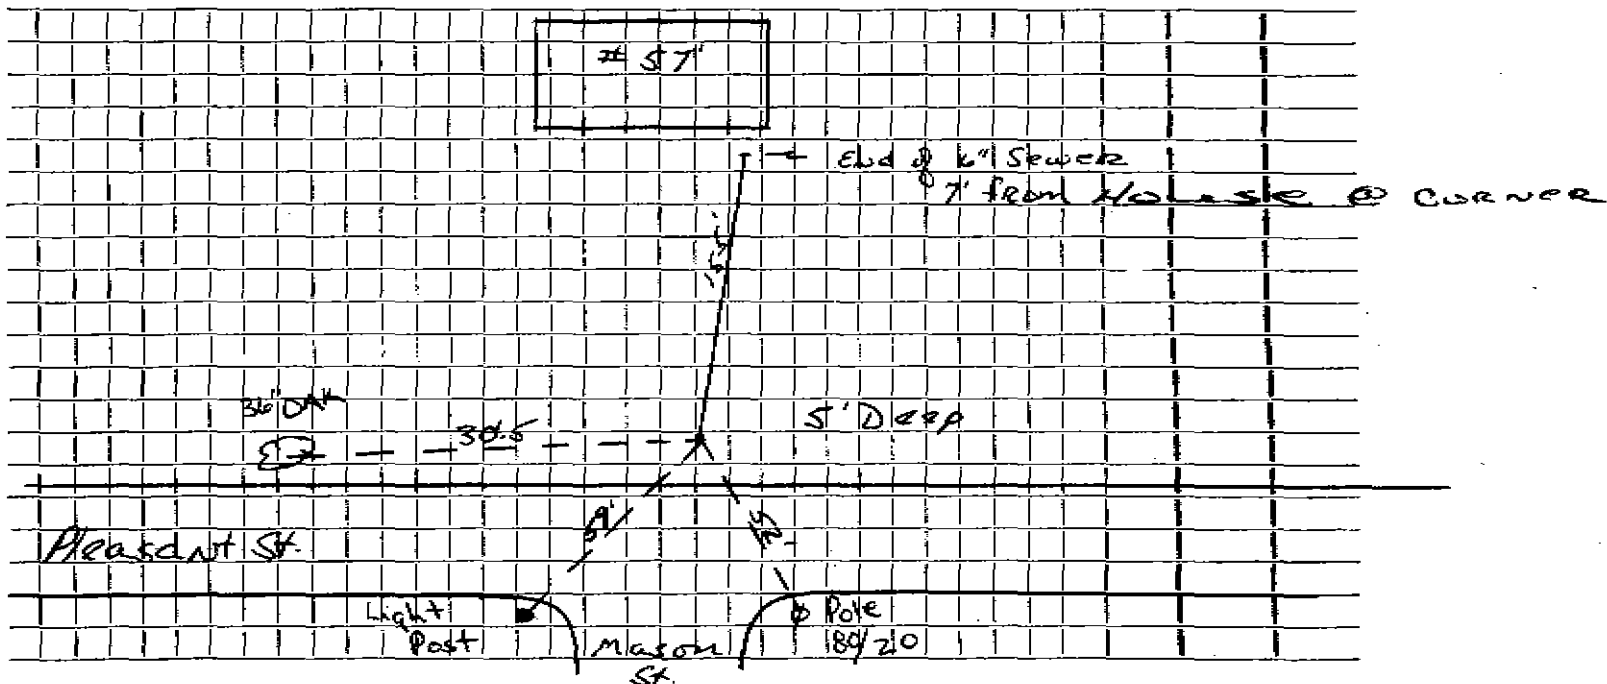

Connection made in Street. Work completed

Remarks: Note: Service not connected at either end.

Pending sewer on Pleasant St.


DATE Nov. 12, 1980

TOWN OF LEXINGTON — BOARD OF PUBLIC WORKS

SEWER DIVISION

Sketch of Service Here

57

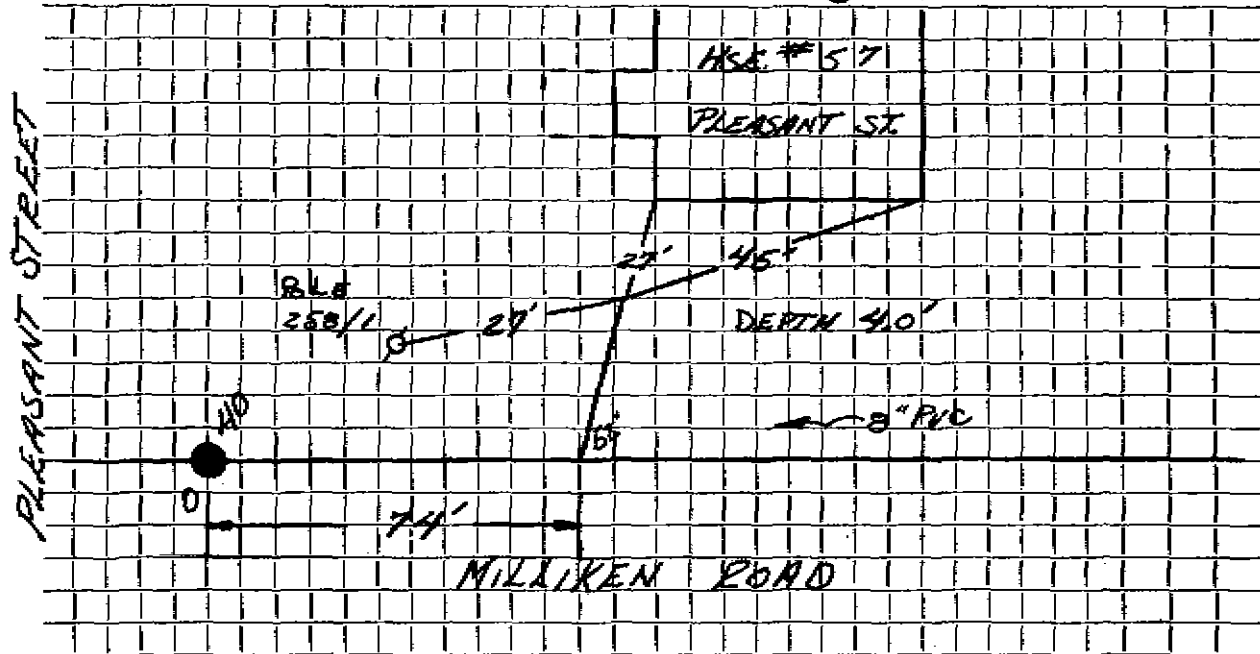

Connection made in MILLIKEN Street. Work completed NOV. 12, 1980

Remarks:

.....

.....