

Name Ben Franklin Homes

Service No. 135

Address 64 Pleasant Street

Location

Kind of Pipe

Size

Size of Main

~~XXXXXXXXXXXX~~ New Service W.O. # 9180

Russell Sidley # 1283

Location

DEC 31 1970


Date	Material	Amount	Total	Date	Amount
1/23/70	Labor	55 50		11-16-70	490 00
1/24/70	"	108 04		1-18-71	161 49
2/3/	"	28 59	192 13		328 51
	10% O. H.		19 21		
	30' 6" Transite pipe ,90		27 00		
	1 6x6 Tee		7 41		
	1 Plug		2 11		
	1/4 Bag cement 1,80		90		
	1 Ton cold patch		6 00		
	3 Ton hot top 6,00		18 00		
	2 1/2 Hrs. trucking 3,00		7 50		
	1 1/2 " 1,50		2 25		
	2 : compressor 5,00		10 00		
	2 " shovel 6,50		13 00		
	4 " loader 5,00		20 00		
	1/2 " roller 2,00		1 00		
	trailer		2 00		
1-70	191' 6" Transite piping		328 51		
1-70	10' 4" Cast Iron pipe				

DATE _____

TOWN OF LEXINGTON — BOARD OF PUBLIC WORKS
SEWER DIVISION

Sketch of Service Here

64

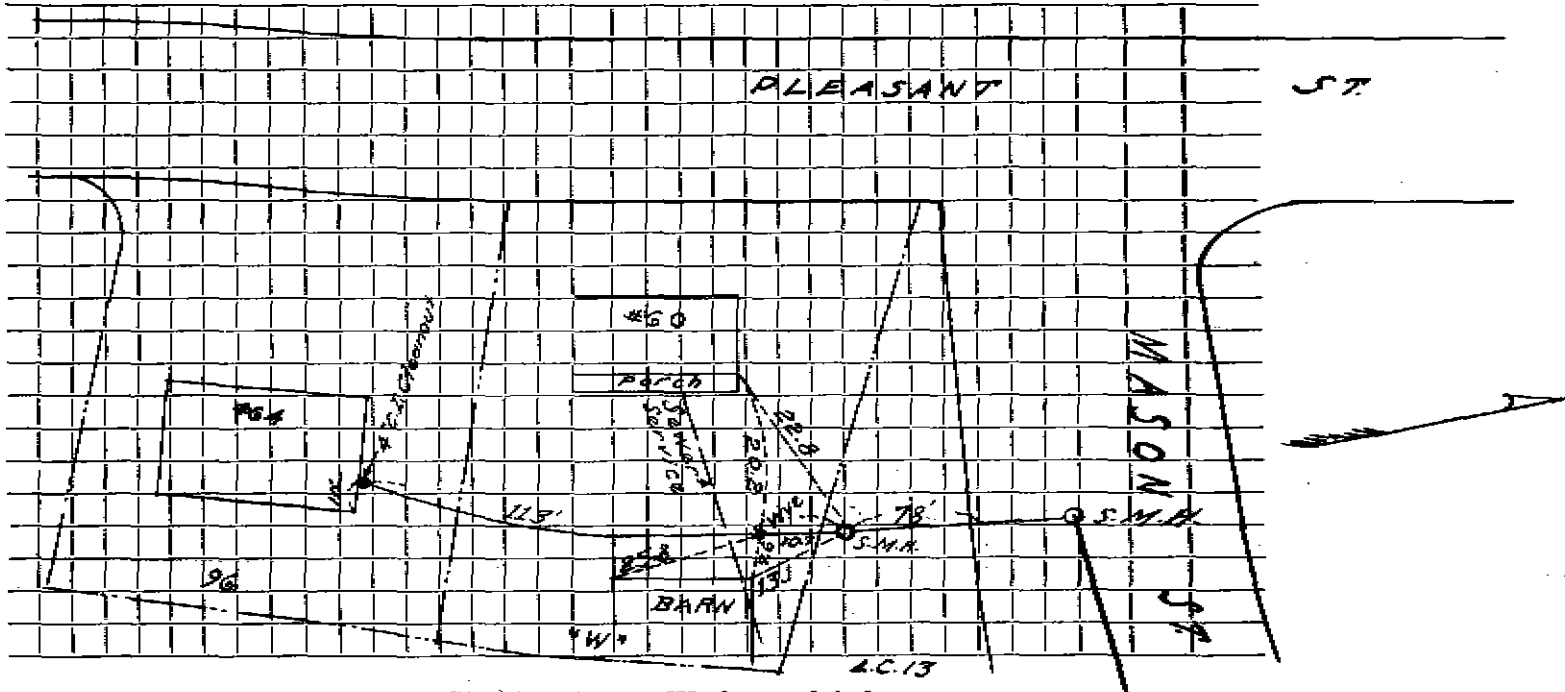

Connection made in Street. Work completed

Remarks:

.....

.....