

Name Clesson C. Schofield

Service No. 137 - 1950

Address 7 Pleasant Street

Location 7 Pleasant Street

Kind of Pipe

Size

Size of Main

~~Repaired~~ New Service

Com. 5/28/51

Location

Date	Material	Amount	Total	Date	Amount
3/12/51	Labor	70 58		12-27-50	Deposited 225 00
	"	38 50	109 08	4-2-51	Refunded (17 89)
	10% Overhead		10 91		207 11
	86'-6" Sewer Pipe @ .344		29 58		
	1-6" Elbow		1 88		
	Joint Compound		5 16		
	7 Hrs. Littlefield Shovel @ 5.		35 00		
	2 Hrs. Trucking		1 50		
	Patching 14 x 3		14 00	8/27	report & invoice (Bill)
			207 11	8-27-51	Roots
				9-19-51	Roots
	Labor				

TOWN OF LEXINGTON—DEPT. OF PUBLIC WORKS
SEWER DIVISION

DATE

NO.


The undersigned applies for the construction of a particular sewer connecting No.
Street and hereby agrees to comply with the Rules and Regulations governing the construction and use of Particular
Sewers, as now or at any future time established by the Board of Selectmen.

Am't of estimate \$.....

Am't Paid \$.....

..... Owner

Sketch of Service Here

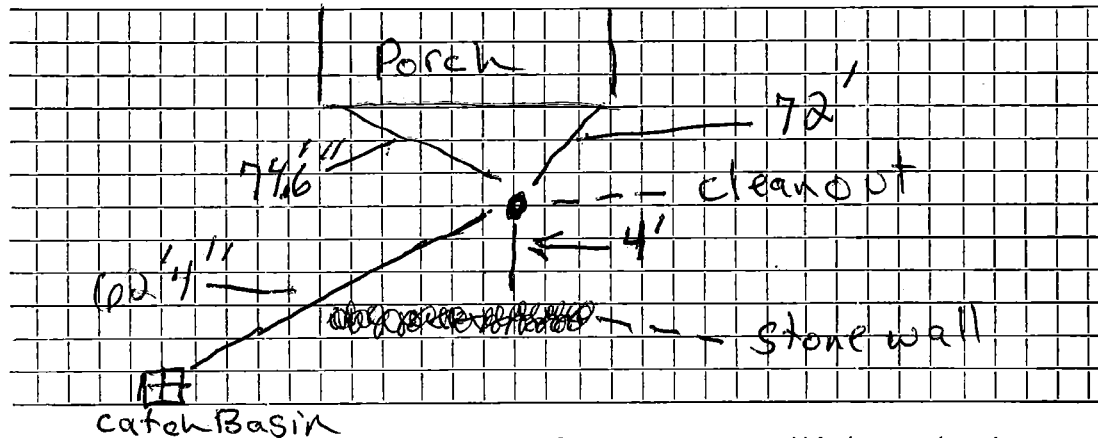

Connection made in Street.

Work completed 19..

Remarks: