

Name

Service No.

Address 94 Pleasant Street

Location

Kind of Pipe

Size

Size of Main

Repair—Renewal—New Service

Easement Per Peter

Location

Date

Material

Amount

Total


Date

Amount

DATE _____

TOWN OF LEXINGTON — BOARD OF PUBLIC WORKS
SEWER DIVISION

Sketch of Service Here

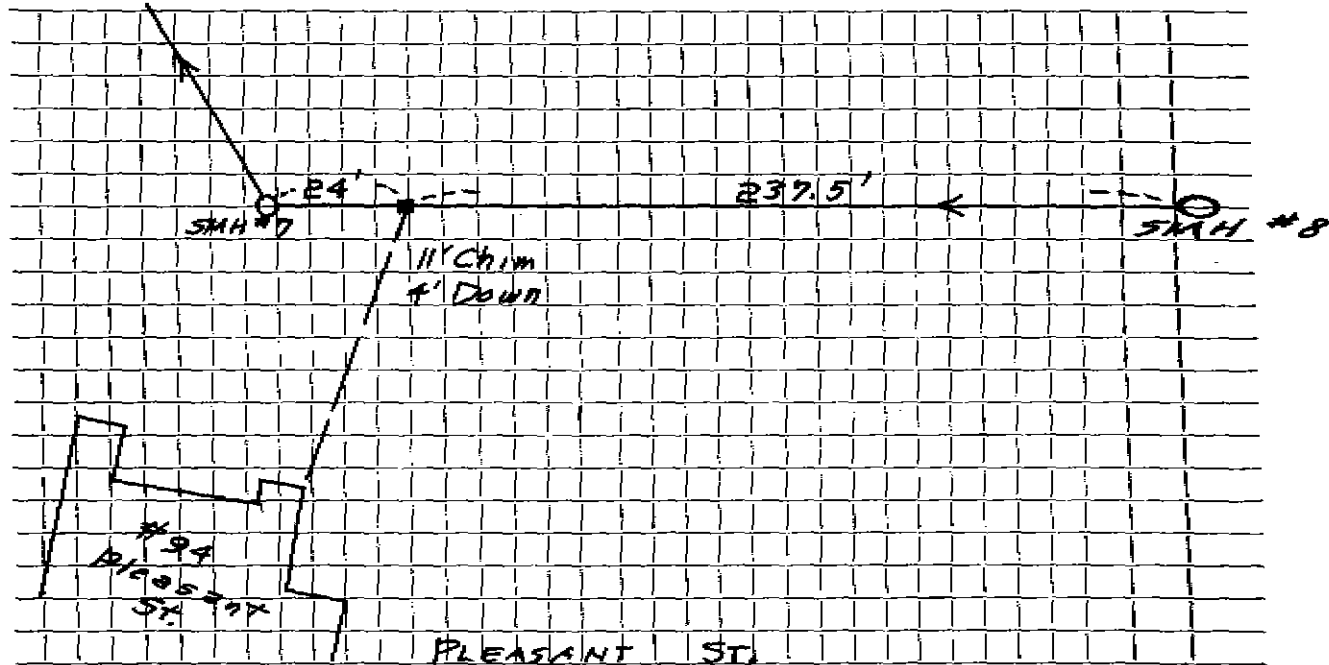

Connection made in Street. Work completed

Remarks:


.....

.....

TOWN OF LEXINGTON — BOARD OF PUBLIC WORKS


SEWER DIVISION

DATE

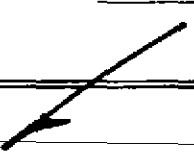

94

Sketch of Service Here

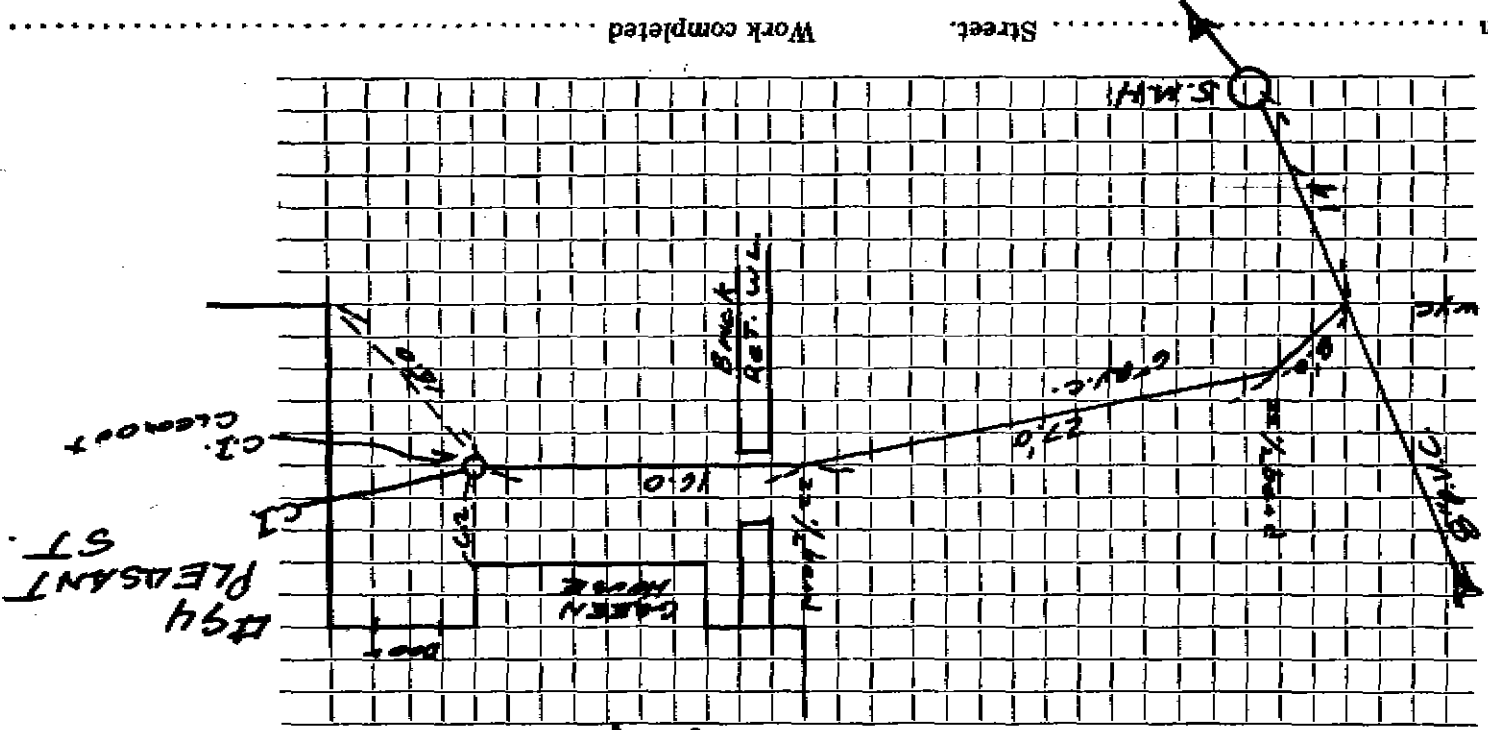

Work completed

Street.

Connection made in

Remarks: