

Name

Service No.

Address

Vacant lot Pleasant St.

Location

Between
~~1st~~ Hse #29
Hse #23

Kind of Pipe

A. C.

Size

6"

Size of Main

8"

Repair—Renewal—New Service

Location

Date

9/7/79

Material

22' of 6" RCP @

Amount

17.00/ft.

Total

\$ 374.00


Date

Amount

DATE _____

TOWN OF LEXINGTON — BOARD OF PUBLIC WORKS
SEWER DIVISION

Sketch of Service Here

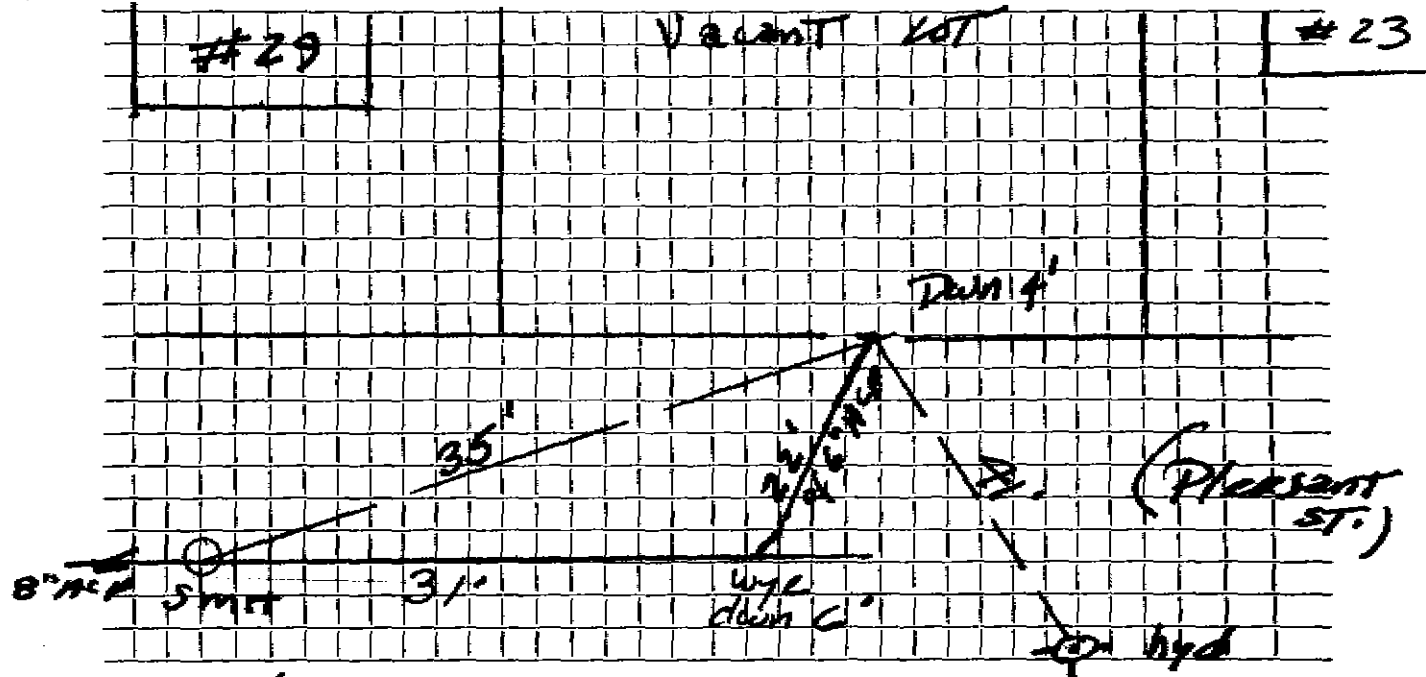

Connection made in Pleasant Street. Work completed

Remarks:
.....
.....