


DATE 12-22-02

TOWN OF LEXINGTON — BOARD OF PUBLIC WORKS
SEWER DIVISION

Sketch of Service Here

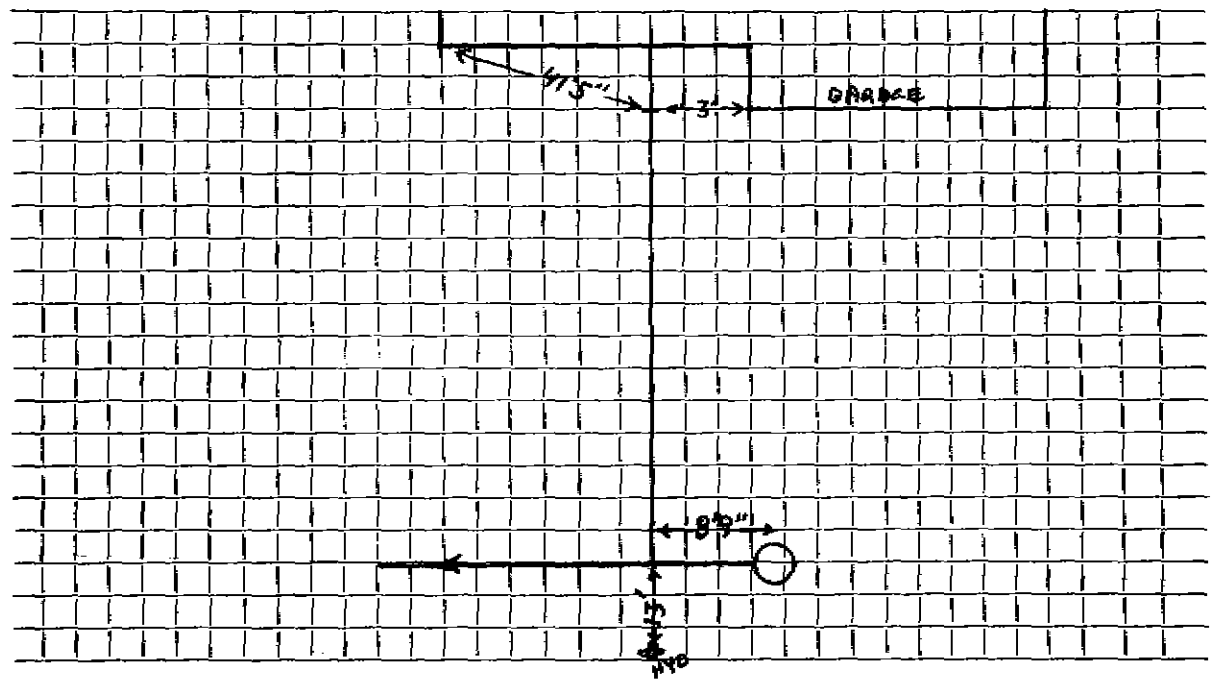

Connection made in Plymouth Rd Street. Work completed 12-22-02

Remarks: SEWER MAIN BROKE WHILE BEING TAPPED. REPAIRED WITH 2'x8\"/>