

W. H. Hart Co. Boston

Service No. 35434

Address 52 Milton St., Arlington,

11 Plymouth Rd.

Lot 29, #11 Plymouth Road.

Kind of Pipe

Size 6"

Size of Main 8"

Repair—Renewal—New Service

Location

Date 1939	Material	Amount	Total	Date	Amount
August 18. <i>9/11/39</i>	Water & Sewer installed to curb in 1936.			<i>Aug 16, 1939 Deposited</i>	50 00
	36' 6" Pipe @ 20¢		7 20		
	1 6" 1/8 Bend		60		
	Jointing compound		2 16		
	2 hrs. Trucking @ 75¢		1 50		
			11 46		
	Charge \$50.00 (to cover cost of work done in 1936.)				
	Labor				

Holley Press, Inc., Lexington

TOWN OF LEXINGTON—BOARD OF PUBLIC WORKS  
SEWER DIVISION

DATE August 9, 1939

NO. \_\_\_\_\_

The undersigned applies for the construction of a particular sewer connecting No. 11 Plymouth Rd. Street and hereby agrees to comply with the Rules and Regulations governing the construction and use of Particular Sewers, as now or at any future time established by the Board of Selectmen.


Am't. of Estimate \$ 50 - flat rate

Am't. Paid \$ \_\_\_\_\_

Julius H. Larson Owner

owner has trench dug

Sketch of Service Here

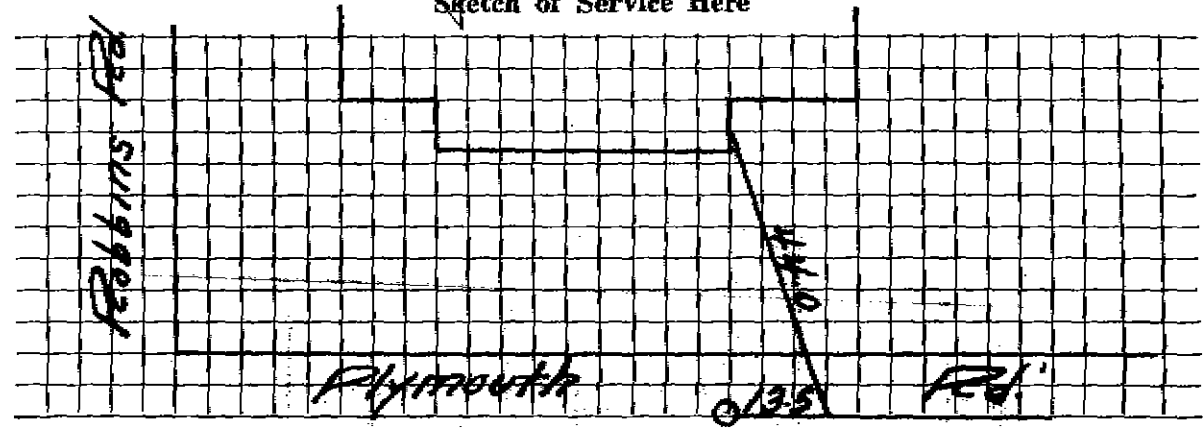

Connection made in \_\_\_\_\_ Street.

Work completed \_\_\_\_\_ 19

Remarks: