

Mr. James H. Smith

Service No. 333

Address 154 Highland Ave., Arlington

18 Plymouth Rd

Location Lot. C, Plymouth Rd.

Kind of Pipe

Size 6"

Size of Main 8"

Business Purpose - New Service

Location

Date	Material	Amount	Total	Date	Amount
5/22/34	70' 16" Sewer Pipe @ .15	\$10 50			
8-21-34	Sulphur & Jute	2 80			
Completed	Trucking	75	\$14 05	June 20 1934 - 14 paid	27 50
	Trench to main by owner				
	Aug 21 Refunded		10 45		
			27 50		
	Labor				

franch by...

TOWN OF LEXINGTON—BOARD OF PUBLIC WORKS
SEWER DIVISION

Harold Liddick 7/1/34
#12 NO.

DATE June 21, 1934


The undersigned applies for the construction of a particular sewer connecting No. Lot 6, Plymouth St.
Street and hereby agrees to comply with the Rules and Regulations governing the construction and use of Particular
Sewers, as now or at any future time established by the Board of Selectmen.

Am't. of Estimate \$ 27⁵⁰

Am't. Paid \$ _____

James D. Smith
154 Highland St. Lexington Owner

Sketch of Service Here

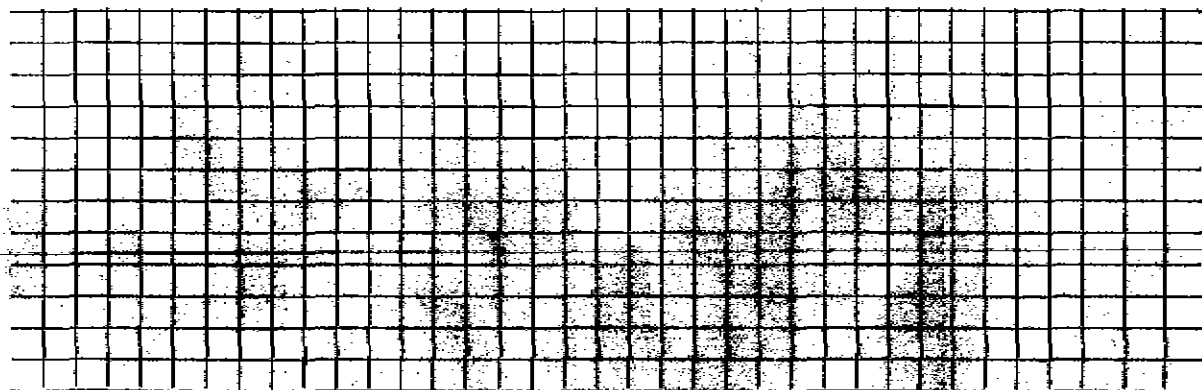

Connection made in _____ Street. Work completed _____ 19