

Name

James T. Smith

Service No. 28 2-28

Address

154 Highland Ave., Arlington

4 Plymouth Road

Location

Lot 13, Plymouth Road

Kind of Pipe

Size 6"

Size of Main 8"

Remarks-Renewals-New Service

Location

Date	Material	Amount	Total	Date	Amount
June, '33	42' 6" S. Pipe @.15	6 30			
9-19-33 Con for 11.53	1 6" 1/8" Bend	70		Oct. 29 1933 - Cash	11 83
	Sulphur & Jute	1 68			
	Trucking	75	9 43		
4	Hrs. Labor @.60	2 40	2 40		
			11 83		
	Labor				

Hedley Press, Inc., Lexington

*Trench Plug*

TOWN OF LEXINGTON—BOARD OF PUBLIC WORKS

SEWER DIVISION

DATE July 27, 1933

*Lot #4* NO. 13 *Plymouth Rd.*


The undersigned applies for the construction of a particular sewer connecting No. 13 *Plymouth Rd.* Street and hereby agrees to comply with the Rules and Regulations governing the construction and use of Particular Sewers, as now or at any future time established by the Board of Selectmen.

Am't. of Estimate \$ \_\_\_\_\_

Am't. Paid \$ \_\_\_\_\_

*James R. Smith* Owner

Sketch of Service Here

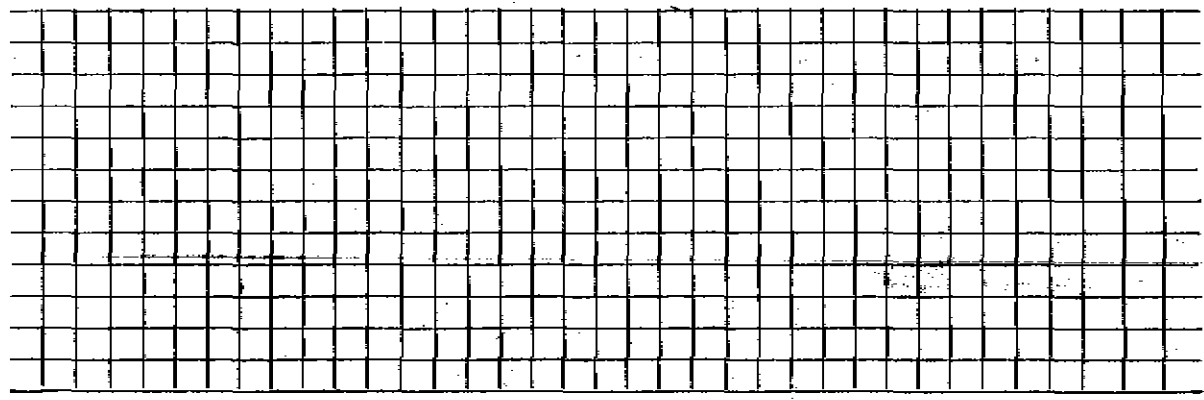

Connection made in \_\_\_\_\_ Street. Work completed \_\_\_\_\_ 19

Remarks: