

Address 9 Plymouth Rd.,

# 9 Plymouth Road

Location 9 Plymouth Rd.,

Kind of Pipe  
Repair—Renewal—New Service

Size 6"      Location  
Size of Main 8"

Date	Material	Amount	Total	Date	Amount
10/11/48	12 hrs. • <u>\$.55</u>	<u>\$.60</u>			
Conn / 10/14/48	36 hrs. • <u>\$.60</u>	<u>21.60</u>			
	2 hrs. • <u>\$.70</u>	<u>1.40</u>	<u>29.00</u>		
	10% Overhead		<u>2.96</u>		
	29' 6" Sewer Pipe	<u>.16</u>	<u>.16</u>		
	16' 1/8 Bend		<u>.65</u>		
	Joint Compound		<u>1.80</u>		
	2 hrs. Trucking	<u>.75</u>	<u>1.50</u>		
	Patching, 9' x 2'		<u>10.00</u>		
			<u>51.16</u>		
	Charge	<u>\$40.00</u>			
	Labor				

TOWN OF LEXINGTON—BOARD OF PUBLIC WORKS  
SEWER DIVISION

DATE Oct 3

NO.

The undersigned applies for the construction of a particular sewer connecting No. 9 Plymouth Rd Street and hereby agrees to comply with the Rules and Regulations governing the construction and use of Particular Sewers, as now or at any future time established by the Board of Selectmen.


Am't. of Estimate \$ 40 00.

Am't. Paid \$ \_\_\_\_\_

*Ella A. Rickey*

Owner

Sketch of Service Here

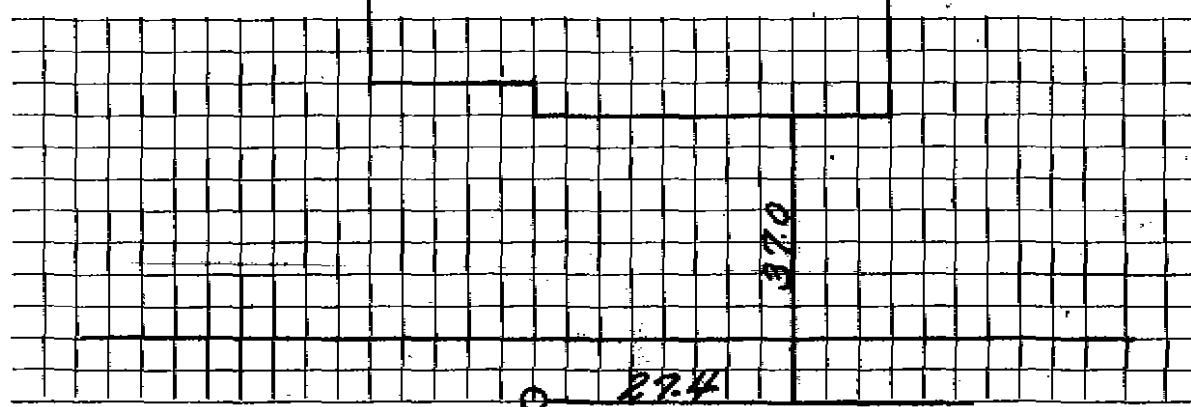

Connection made in \_\_\_\_\_ Street. Work completed \_\_\_\_\_ 19\_\_\_\_\_

Remarks: