


DATE _____

TOWN OF LEXINGTON — BOARD OF PUBLIC WORKS

SEWER DIVISION

Sketch of Service Here

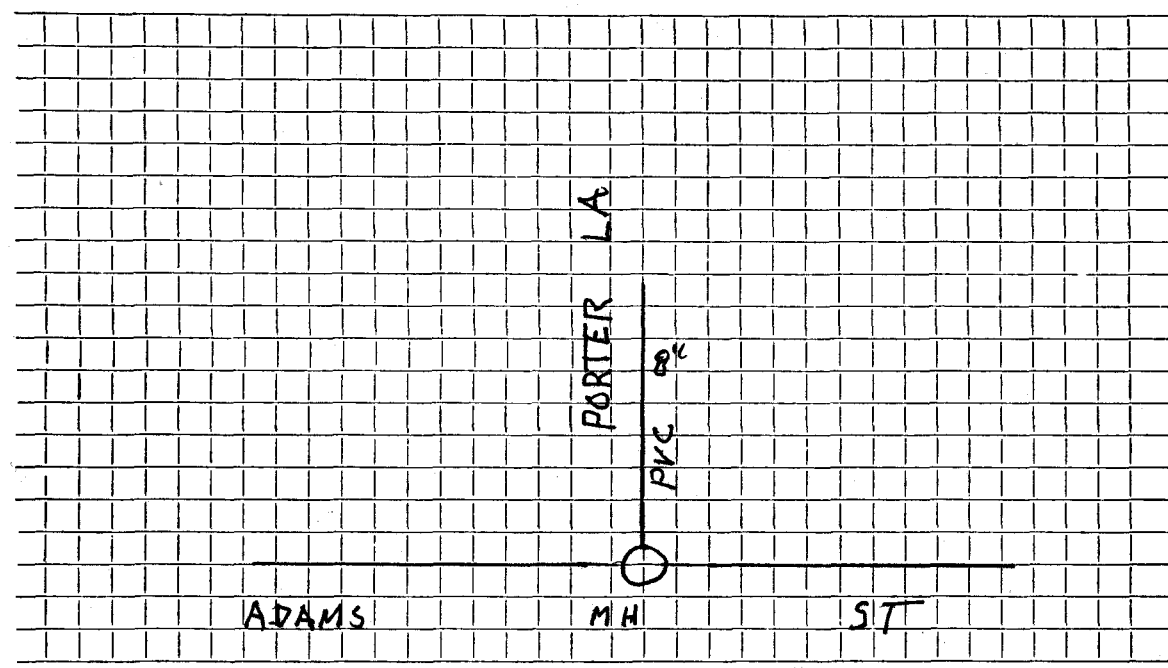

Connection made in ADAMS.....ST..... Street. Work completed

Remarks:
.....
.....