


DATE 3-2-00

TOWN OF LEXINGTON — BOARD OF PUBLIC WORKS
SEWER DIVISION

Sketch of Service Here

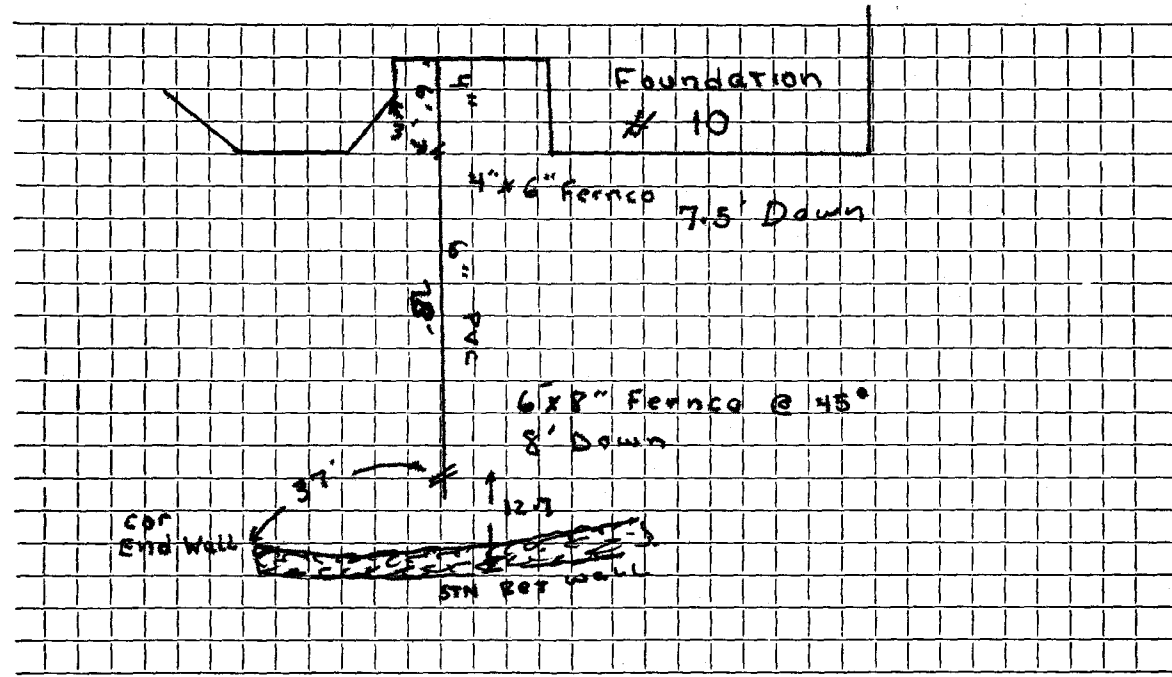

Connection made in Porter Lane Street. Work completed 3-2-00

Remarks:

.....

.....