


DATE 9-24-2001

TOWN OF LEXINGTON — BOARD OF PUBLIC WORKS
SEWER DIVISION

Sketch of Service Here

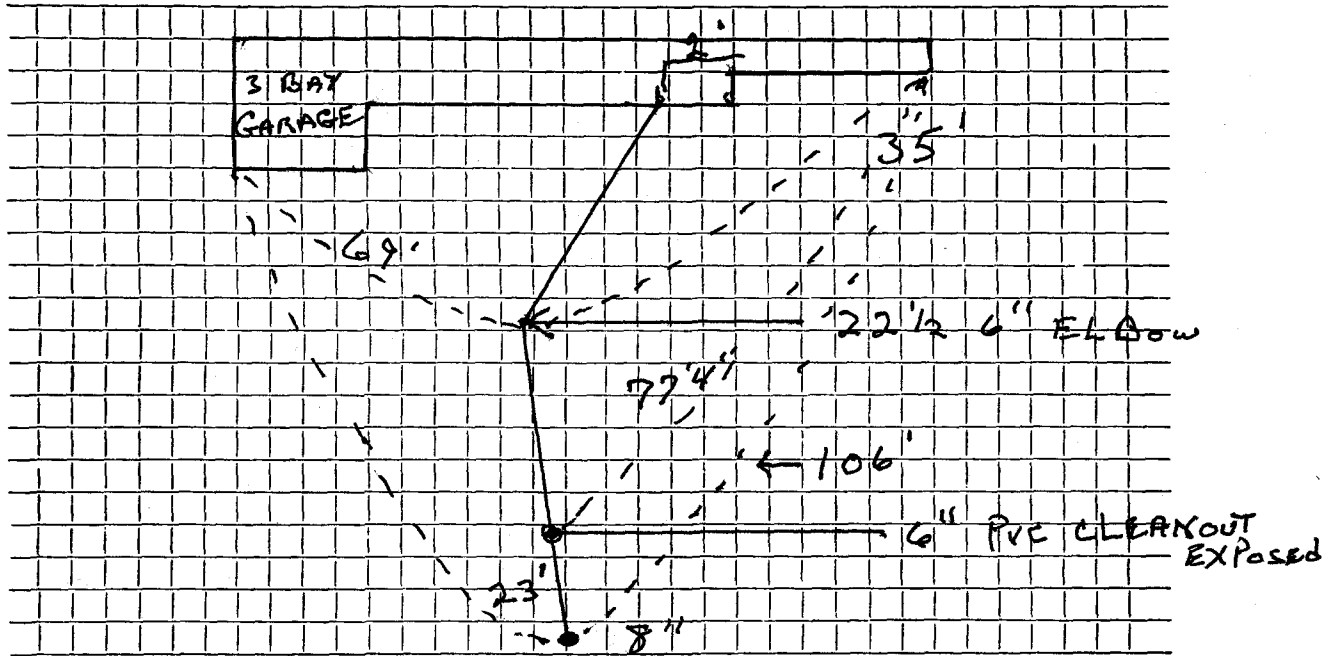

Connection made in PANTER LN Street. Work completed

Remarks: INSTALLED BY J. McLAUGHLIN