


DATE 10-1-01

TOWN OF LEXINGTON — BOARD OF PUBLIC WORKS

SEWER DIVISION

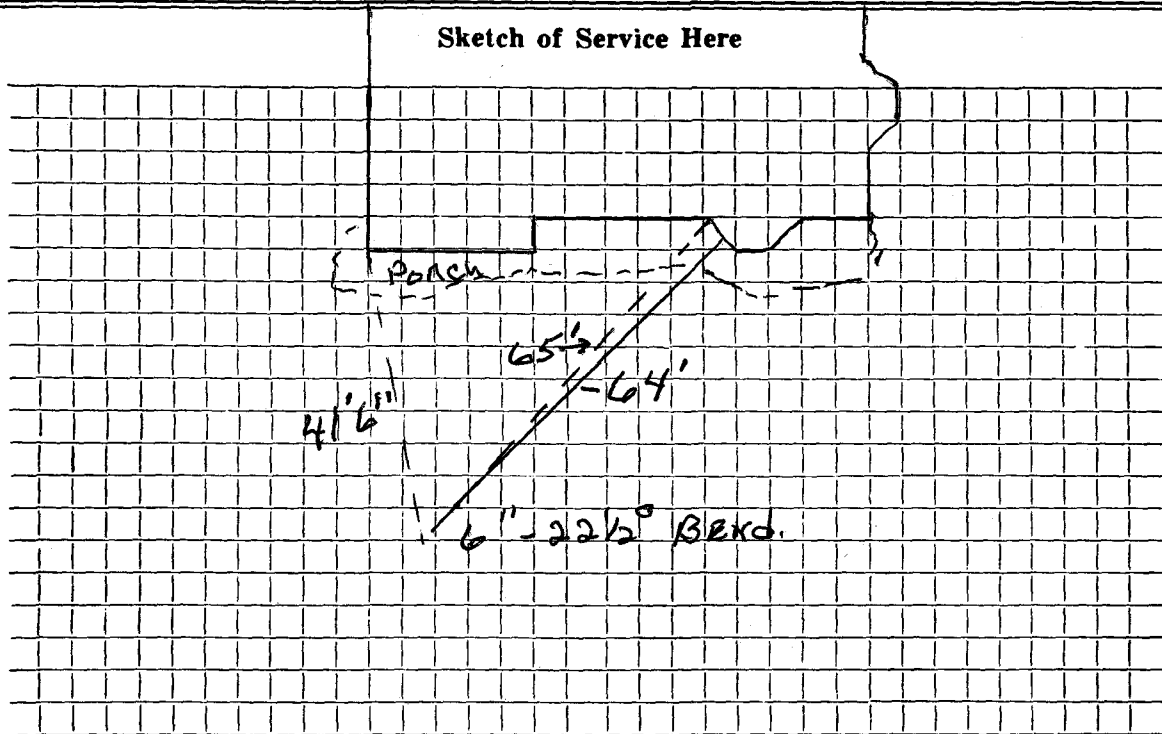

Connection made in PORTER LN Street. Work completed

Remarks: INSTALLED BY J. McLAUGHLIN

.....
.....