


DATE 10-1-01

TOWN OF LEXINGTON — BOARD OF PUBLIC WORKS
SEWER DIVISION

Sketch of Service Here

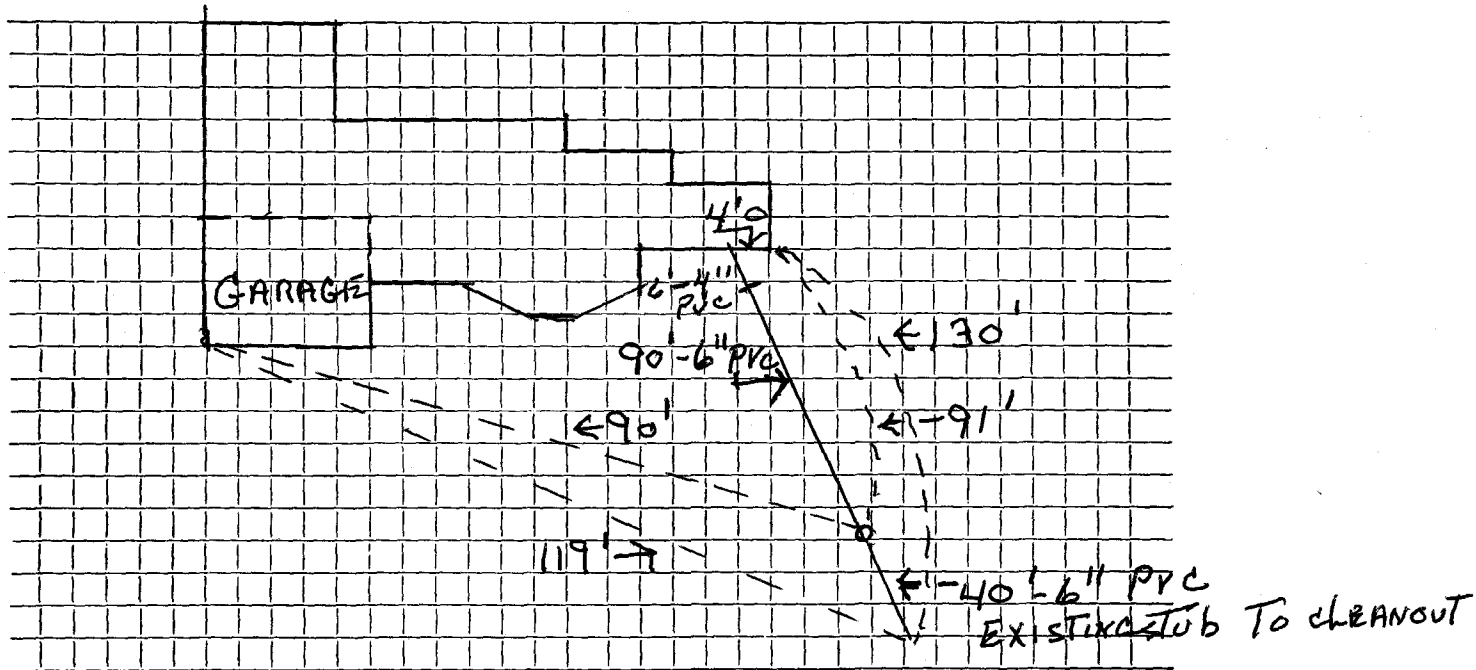

Connection made in PORTER LN Street. Work completed

Remarks: J. M. CLAUGHLIN

.....

.....