




DATE 12/20/99

TOWN OF LEXINGTON — BOARD OF PUBLIC WORKS  
SEWER DIVISION

Sketch of Service Here

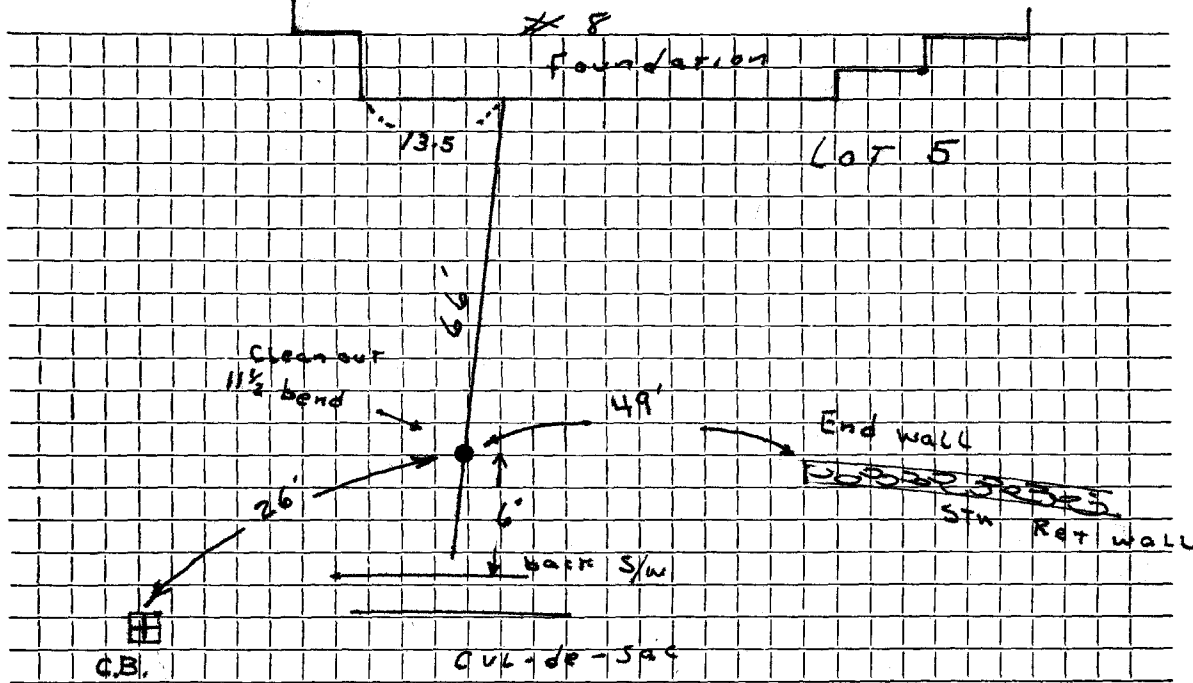

Connection made in Porter Lane Street. Work completed .....

Remarks: .....