

Name

Service No.

Address 21 Preston Road -

21 Preston Road

Location

Kind of Pipe

Size 6"

Size of Main 8"

~~Repair/ Renewal~~ - New Service SEWER SERVICE TO CURB-TO BE CHARGED WHEN CONNECTED

Location

Date	Material	Amount	Total	Date	Amount
------	----------	--------	-------	------	--------

Outside

9/10/52

Labor

8 82

10% Overhead

88

9 70

10' - 5" transite pipe @ .55

5 50

1 - 6" elbow

1 88

2 hrs. Brox shovel @ 10.00

20 00

1 hr. trucking

75

3-24-53

Inside

37 83

36' 5" Transite

Labor

# TOWN OF LEXINGTON—DEPT. OF PUBLIC WORKS

## SEWER DIVISION

DATE.....

NO. ....

The undersigned applies for the construction of a particular sewer connecting No.....  
 Street and hereby agrees to comply with the Rules and Regulations governing the construction and use of Particular  
 Sewers, as now or at any future time established by the Board of Selectmen.


Am't of estimate \$.....

Am't Paid \$.....

..... Owner

Sketch of Service Here

21

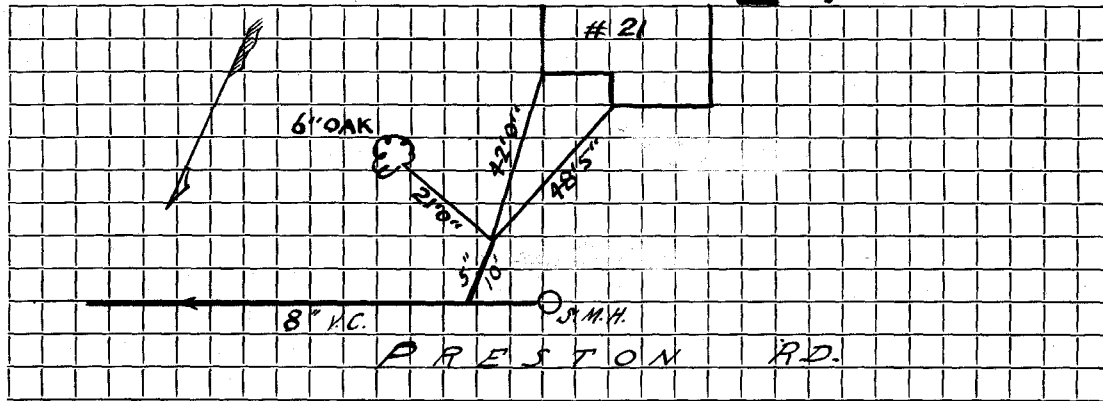

Connection made in..... Street.

Work completed.....19..

Remarks: