

Name

Service No.

Address

24 Preston Road  
Lexington

Location

Kind of Pipe

Size 6"

Size of Main 8"

~~Repair/Removal~~—New Service

SEWER SERVICE TO CURB -TO BE CHARGED  
WHEN CONNECTED.

Location

Date	Material	Amount	Total	Date	Amount
	<i>Outside</i>				
9-10-52	Labor	17 64			
	10% overhead	1 76	19 40		
	20' - 5" transite pipe @.55		11 00		
	1 hr. Brox shovel		10 00		
	1 hr. trucking		75		
3-25-53	<i>Inside</i>		41 15		
	<i>36' 5" Transite</i>				
	Labor				

# TOWN OF LEXINGTON—DEPT. OF PUBLIC WORKS

## SEWER DIVISION

DATE.....

NO. ....


The undersigned applies for the construction of a particular sewer connecting No.....  
 Street and hereby agrees to comply with the Rules and Regulations governing the construction and use of Particular  
 Sewers, as now or at any future time established by the Board of Selectmen.

Am't of estimate \$.....

Am't Paid \$.....

..... Owner

Sketch of Service Here **24**

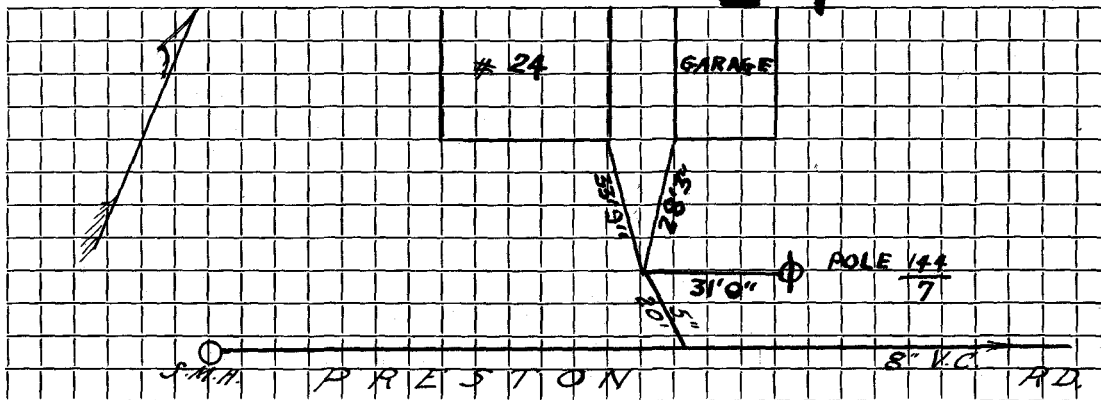

Connection made in..... Street.

Work completed.....19..

Remarks: