

Name John C. Gale

Service No. 181

Address 25 Preston Rd.

25 Preston Road

Location

Kind of Pipe

Size 6"

Size of Main 8"

~~Repair - Renew~~ - New Service SEWER SERVICE TO CURB - TO BE CHARGED
WHEN CONNECTED

Location Comm 2-18-61

Date	Material	Amount	Total	Date	Amount
9/10/52	Labor	11 76		10-26-61	200 00
	10% Overhead	1 18	12 94	2-13-62	18 78
	1 - 6" elbow		1 88		218 78
	2 2/3 hrs. Brox shovel @10.00		26 67		Non-Charge
	10' - 5" transite pipe @.55		5 50	10/31/61	Labor 15 94
	1 hr. trucking		75		
			47 74		
10/31/61	Labor 52.45				Shovel broken down - Time taken off.
11/2/61	" 28.94	81 39			
	10% O.H.	8 14	89 53		
	46' 5" Transite Pipe @ .66		30 36		
	1 5" Duplex Adapter		1 55		
	1 1/2" Transite Bend		7 60		
	Labor				
	6 Hrs. Pippin Shovel @ 5.00		30 00		
	4 Hrs. Trucking @ 3.00		12 00		
	Previous Charge		47 74		
			218 78		Bill sent 12-78

TOWN OF LEXINGTON—DEPT. OF PUBLIC WORKS

SEWER DIVISION

DATE.....

NO.

The undersigned applies for the construction of a particular sewer connecting No.....
 Street and hereby agrees to comply with the Rules and Regulations governing the construction and use of Particular
 Sewers, as now or at any future time established by the Board of Selectmen.


Am't of estimate \$.....

Am't Paid \$.....

..... Owner

Sketch of Service Here

25

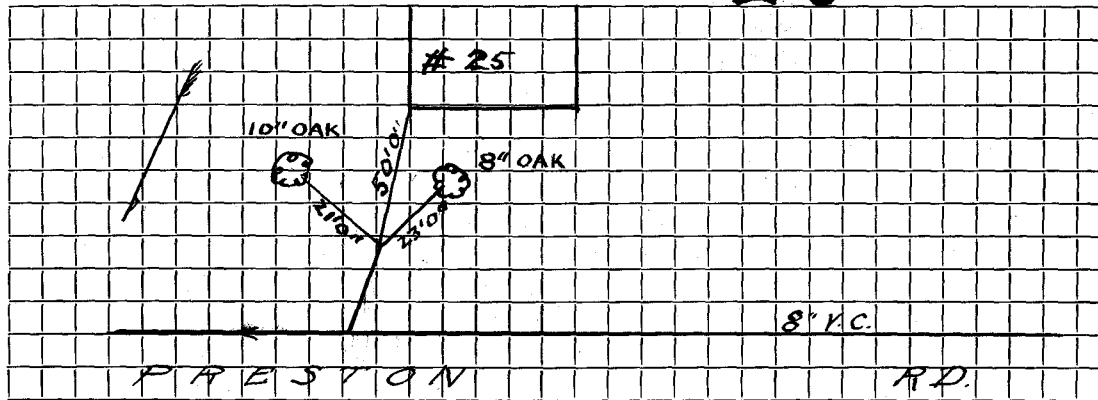

Connection made in..... Street.

Work completed.....19..

Remarks: