

Name

Service No.

Address 26 Preston Road

26 Preston Road

Location

Kind of Pipe

Size 6"

Size of Main 8"

~~Repair~~ ~~Renew~~ ~~New~~ Service

SEWER SERVICE TO CURB-TO BE CHARGED

Location

WHEN CONNECTED

Date	Material	Amount	Total	Date	Amount
	Outside				
9/9/52	Labor	17 64			
	10% Overhead	1 76	19 40		
	30' - 5" transite pipe @.55		16 50		
	4 hrs. Brox shovel @10.00		40 00		
	1 hr. trucking		75		
3-13-57	Inside		76 65		
	37' 6" Transite				
	Labor				

TOWN OF LEXINGTON—DEPT. OF PUBLIC WORKS

SEWER DIVISION

DATE.....

NO.


The undersigned applies for the construction of a particular sewer connecting No.....
 Street and hereby agrees to comply with the Rules and Regulations governing the construction and use of Particular
 Sewers, as now or at any future time established by the Board of Selectmen.

Am't of estimate \$.....

Am't Paid \$.....

..... Owner

Sketch of Service Here **26**

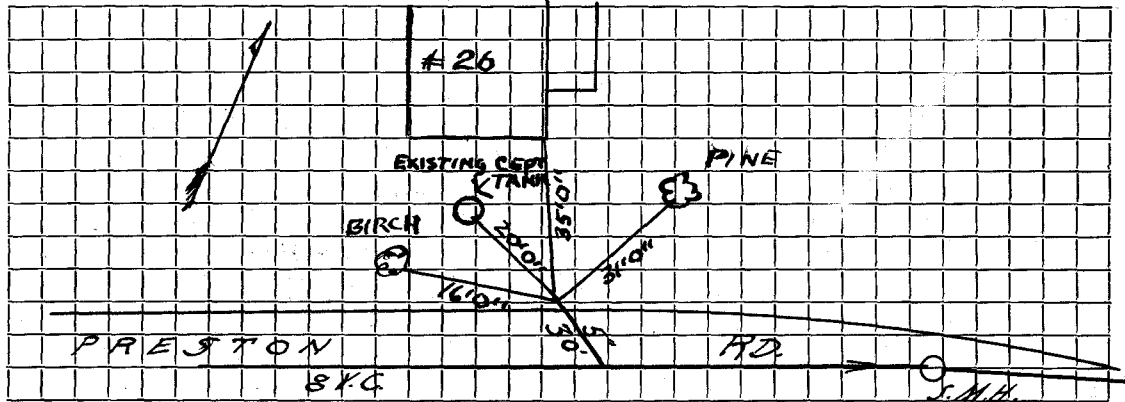

Connection made in..... Street.

Work completed.....19..

Remarks: