

Name

SECTION 011

Service No.

Address

30 Preston Road

30 Preston Road

Location

Kind of Pipe

Size 6"

Size of Main 8"

~~Repair~~ ~~Renew~~ New Service

SEWER SERVICE TO CURB-TO BE CHARGED
WHEN CONNECTED

Location

Date

Material
Outside

Amount

Total

Date

Amount

9/9/52

Labor

11 76

10% Overhead

1 18

12 94

20' - 5" transite pipe @.55

11 00

2 2/3 hrs. Brox shovel @10.00

26 67

1 hr. trucking

75

51 36

4-16-53

Inside

31' 5" Transite

Labor

TOWN OF LEXINGTON—DEPT. OF PUBLIC WORKS

SEWER DIVISION

DATE.....

NO.

The undersigned applies for the construction of a particular sewer connecting No.....
Street and hereby agrees to comply with the Rules and Regulations governing the construction and use of Particular
Sewers, as now or at any future time established by the Board of Selectmen.


Am't of estimate \$.....

Am't Paid \$.....

..... Owner

Sketch of Service Here

30

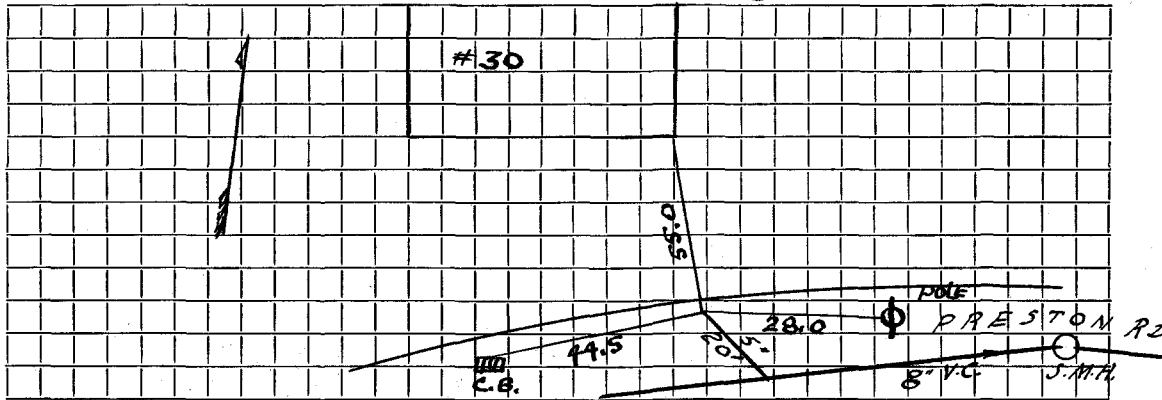

Connection made in..... Street.

Work completed.....19..

Remarks: