

Name John Wathen

Service No. 35

Address 31 Preston Rd.

Lexington

Location

Kind of Pipe

Size

Size of Main

~~Repair-Renewal~~ New Service

COM. 4-6-53

Location

Date	Material	Amount	Total	Date	Amount
3/23/53	Labor	68 03		3-19-53	Deposited 150 00
	10% overhead	6 80	74 83	4-6-53	Refunded (6 32)
	48'-5" Transite Pipe .55		26 40	9-9-52	143 68
	1 Hr. Town Shovel @5.00		5 00	10' 5" Transite	
	2 Hr. Trucking		1 50		
			107 73		
			Plus attached card: (35 95)		
			143 68		
	Labor				

TOWN OF LEXINGTON—DEPT. OF PUBLIC WORKS
SEWER DIVISION

DATE.....

NO.


The undersigned applies for the construction of a particular sewer connecting No.....
 Street and hereby agrees to comply with the Rules and Regulations governing the construction and use of Particular
 Sewers, as now or at any future time established by the Board of Selectmen.

Am't of estimate \$.....

Am't Paid \$.....

..... Owner

Sketch of Service Here

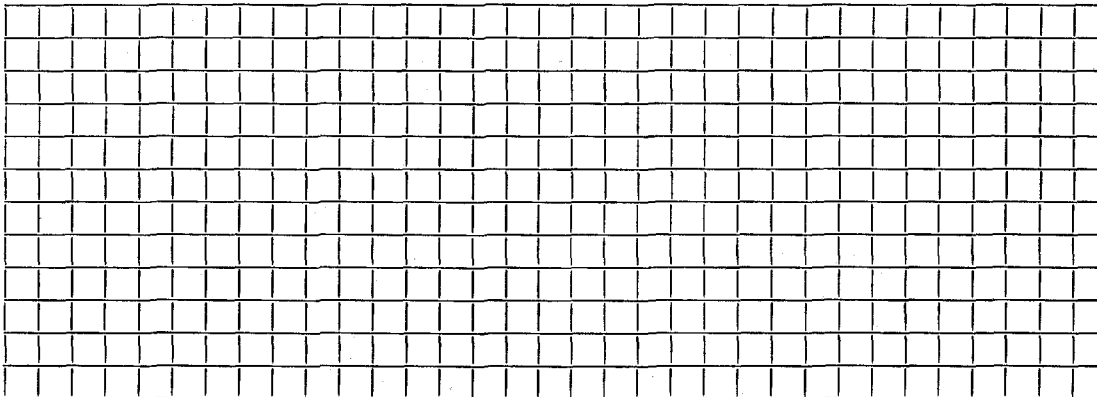

Connection made in..... Street.

Work completed.....19..

Remarks: