

Name

Service No.

Address 35 Preston Road

35 Preston Road

Location

Kind of Pipe

Size 6"

Size of Main 8"

~~Repair/Repair~~ New ServiceSERVICE TO CURB - TO BE CHARGED
WHEN CONNECTED.

Location

Date

Material
Outside

Amount

Total

Date

Amount

9/8/52

Labor

26 46

10% overhead

2 65

29 11

30' - 5" transite pipe @ .55

16 50

1 - 6" elbow

1 88

1 hr. Brox shovel

10 00

1 hr. trucking

754-3-53 **Inside**

58 24

74' 5" Transite

1 5" 1/8° Bend

Labor

TOWN OF LEXINGTON—DEPT. OF PUBLIC WORKS

SEWER DIVISION

DATE.....

NO.


The undersigned applies for the construction of a particular sewer connecting No.....
 Street and hereby agrees to comply with the Rules and Regulations governing the construction and use of Particular
 Sewers, as now or at any future time established by the Board of Selectmen.

Am't of estimate \$.....

Am't Paid \$.....

..... Owner

Sketch of Service Here **35**

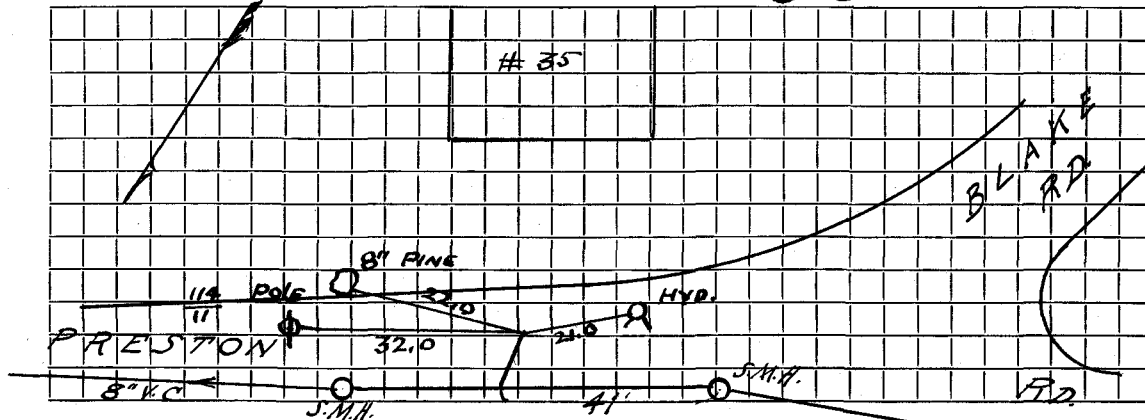

Connection made in..... Street.

Work completed.....19..

Remarks: