

Name

Service No.

Address 37 Preston Road

37 Preston Road

Location

Kind of Pipe

Size 6"

Size of Main 8"

~~Repair/Replace~~ New Service

SEWER SERVICE TO CURB - TO BE CHARGED WHEN CONNECTED.

Location

Date	Material	Amount	Total	Date	Amount
	Outside				
9/5/52	Labor	22 05			
	10% overhead	2 21	24 26		
	30' - 5" transite pipe @ .55		16 50		
	1 - 6" elbow		1 88		
	1 hr. Brox shovel		10 00		
	1 hr. trucking		75		
4-3-53	Inside		53 39		
	35' 5" Transite				
	1 5"- 1/8° Bend				
	Labor				

TOWN OF LEXINGTON—DEPT. OF PUBLIC WORKS

SEWER DIVISION

DATE.....

NO.


The undersigned applies for the construction of a particular sewer connecting No.....
 Street and hereby agrees to comply with the Rules and Regulations governing the construction and use of Particular
 Sewers, as now or at any future time established by the Board of Selectmen.

Am't of estimate \$.....

Am't Paid \$.....

..... Owner

Sketch of Service Here **37**

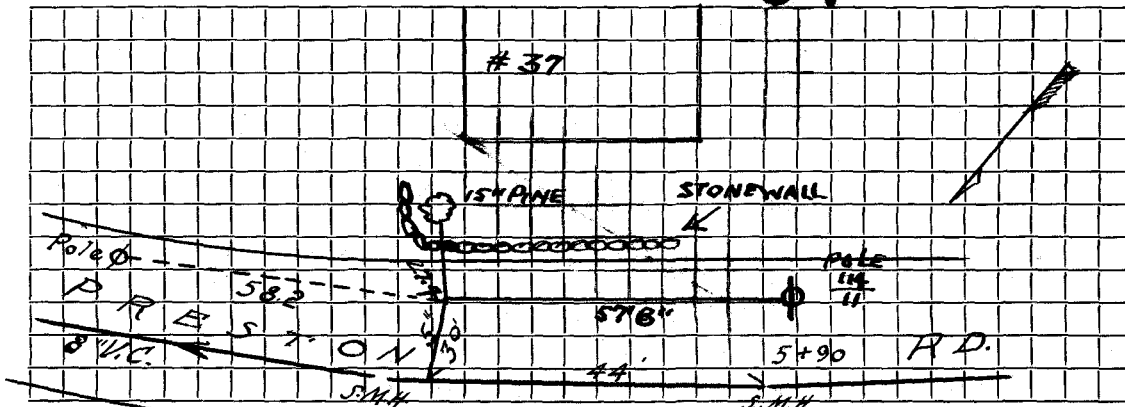

Connection made in..... Street.

Work completed.....19..

Remarks: