

Name

Service No.

Address 39 Preston Road

39 Preston Road

Location

Kind of Pipe

Size 6"

Size of Main 8"

~~Repair - Renewal~~ - New Service SEWER SERVICE TO CURB - TO BE CHARGED WHEN CONNECTED Location

Date	Material	Amount	Total	Date	Amount
	Outside				
9/4/52	Labor	13 23			
9/5/52	Labor	7 35			
	10% Overhead	2 06	22 64		
	24' - 5" transite pipe@.55		13 20		
	4 2/3 hr. Brox shovel@10.00		46 67		
	1 hr. trucking		75		
2-27-63	Inside		83 26		
	20' 5" Transite				
	Labor				
				2-27-67	Sludge
				7-17-64	Sewer Blank

TOWN OF LEXINGTON—DEPT. OF PUBLIC WORKS

SEWER DIVISION

DATE.....

NO.


The undersigned applies for the construction of a particular sewer connecting No.....
 Street and hereby agrees to comply with the Rules and Regulations governing the construction and use of Particular
 Sewers, as now or at any future time established by the Board of Selectmen.

Am't of estimate \$.....

Am't Paid \$.....

..... Owner

Sketch of Service Here **39**

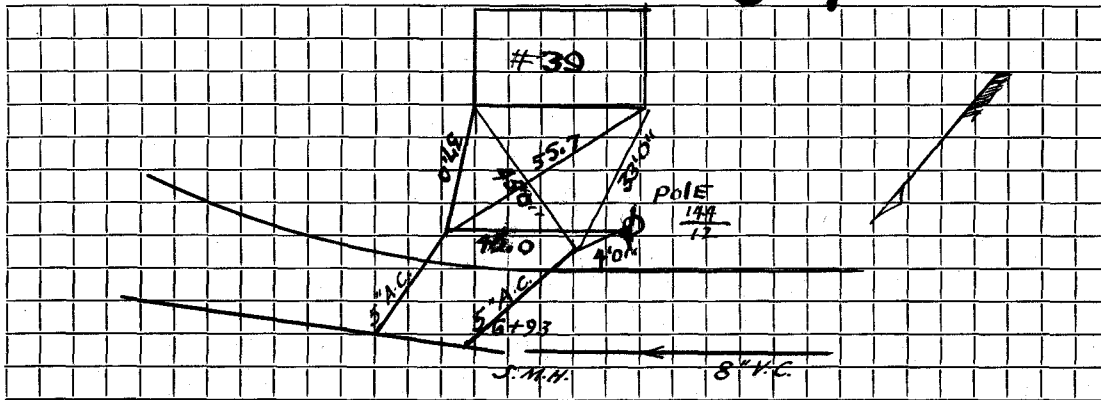

Connection made in..... Street.

Work completed.....19..

Remarks: