


DATE _____

TOWN OF LEXINGTON — BOARD OF PUBLIC WORKS

SEWER DIVISION

Sketch of Service Here

40

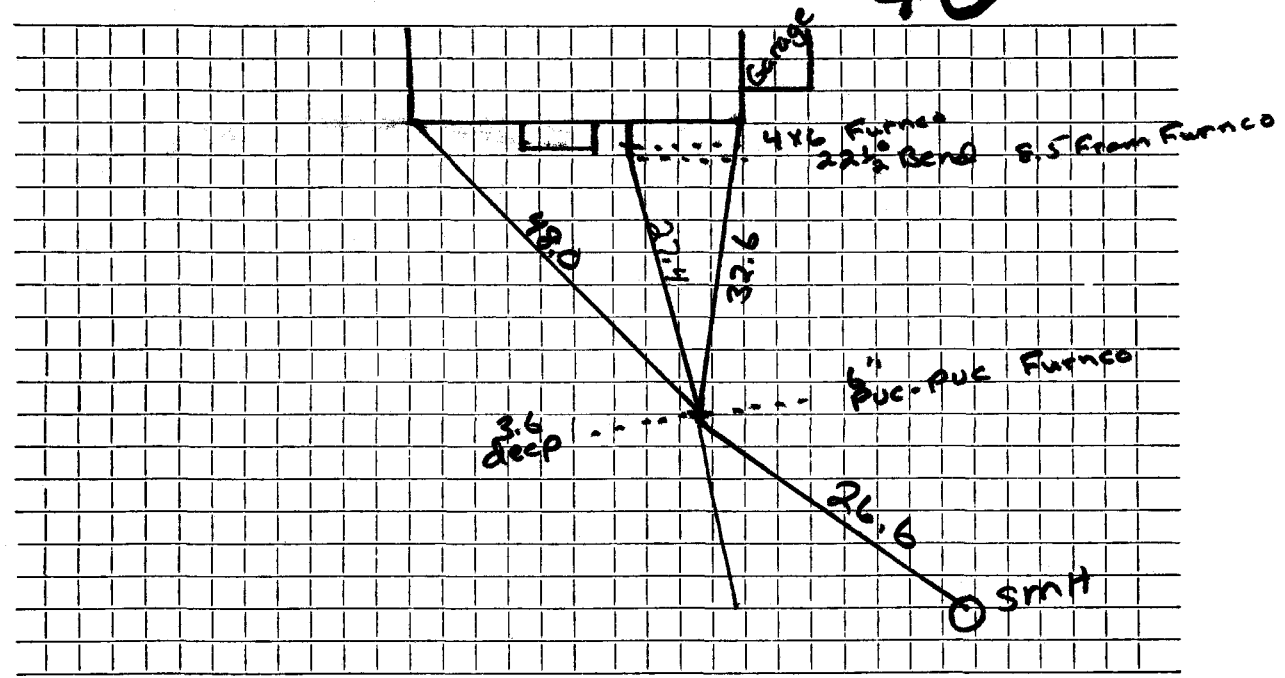

Connection made in Street. Work completed

Remarks: 6" PVC IN the Street

.....

.....