

**Name**

**Service No.**

**Address** 42 Preston Road

Lot 1 & 2

**Location**

**Kind of Pipe**

**Size**

**Size of Main**

**Repair—Renewal—New Service**

**Location**

Date

Material

Amount

Total

Date


Amount

DATE \_\_\_\_\_

# TOWN OF LEXINGTON — BOARD OF PUBLIC WORKS

## SEWER DIVISION

Sketch of Service Here

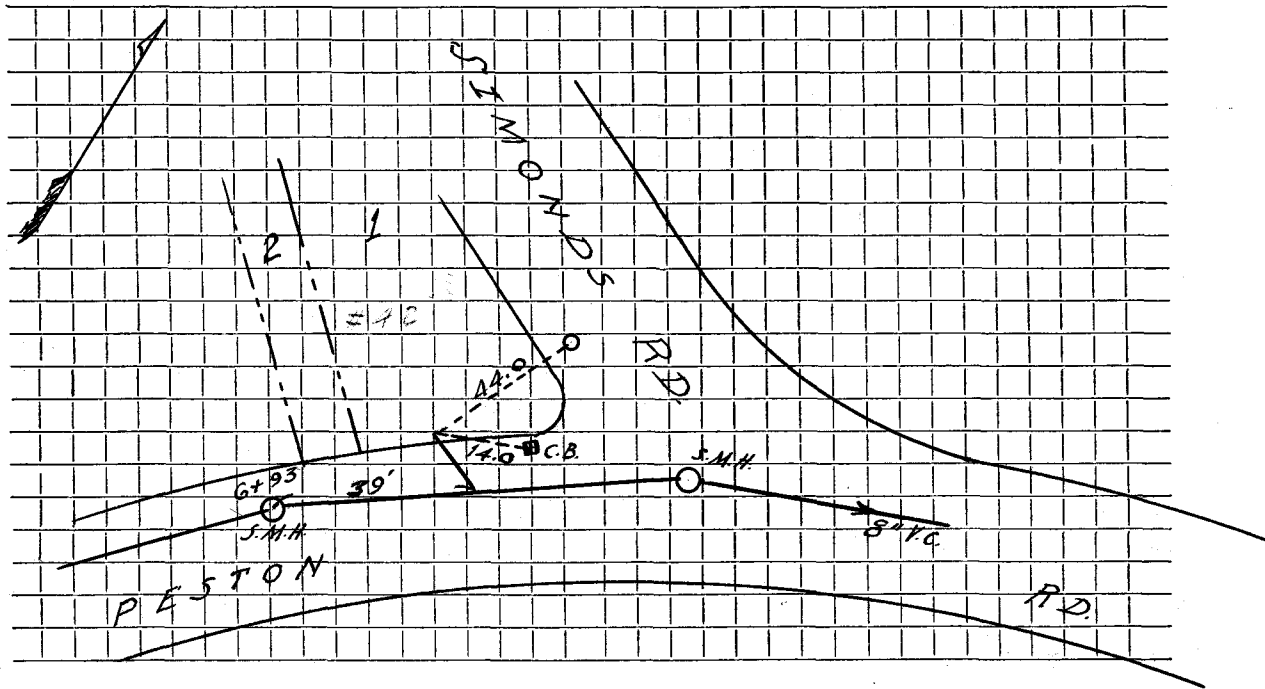

Connection made in ..... Street. Work completed .....

Remarks: .....

.....

.....