

Name

Service No.

Address 10 Preston Rd.

10 Preston Road

Location

Kind of Pipe

Size 6"

Size of Main 8"

~~Repair - Renewal~~ - New Service SEWER SERVICE TO CURB - TO BE CHARGED WHEN CONNECTED

Location

Date	Material	Amount	Total	Date	Amount
	Outside				
9/15/52	Labor	16 16			
	10% Overhead	1 62	17 78		
	20' - 5" transite transite pipe @ .55		11 00		
	1 - 6" elbow		1 88		
	3 2/3 hr. Brox shovel @10.00		36 67		
	1 hr. trucking		75		
3-10-53	Inside		68 08		
	40' 5" Transite				
	Labor				

TOWN OF LEXINGTON—DEPT. OF PUBLIC WORKS

SEWER DIVISION

DATE.....

NO.

The undersigned applies for the construction of a particular sewer connecting No.....
 Street and hereby agrees to comply with the Rules and Regulations governing the construction and use of Particular
 Sewers, as now or at any future time established by the Board of Selectmen.


Am't of estimate \$.....

Am't Paid \$.....

..... Owner

Sketch of Service Here

10

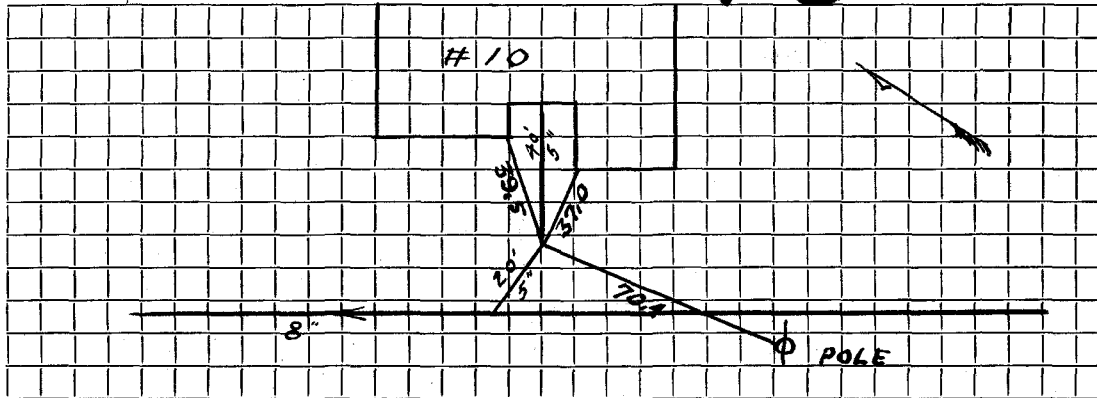

Connection made in..... Street.

Work completed.....19..

Remarks: