

Name

Service No.

Address 11 Preston Road

11 Preston Road

Location

Kind of Pipe

Size 6"

Size of Main 8"

~~Repaired/Revised~~—New Service SEWER SERVICE TO CURB TO BE CHARGED WHEN CONNECTED

Location

Date

Material  
*Outside*

Amount

Total

Date

Amount

9/15/52

Labor

13 25

14 58

10% Overhead

1 33

30' - 5" ~~transite~~ ~~transite~~ pipe @.55

16 50

1 - 6" elbow

1 88

3 hrs. Brox shovel @10.00

30 00

1 hr. trucking

75

63 71

6-10-54

*Inside*

22' 6" Transite

Labor

# TOWN OF LEXINGTON—DEPT. OF PUBLIC WORKS

## SEWER DIVISION

DATE.....

NO. ....


The undersigned applies for the construction of a particular sewer connecting No.....  
Street and hereby agrees to comply with the Rules and Regulations governing the construction and use of Particular  
Sewers, as now or at any future time established by the Board of Selectmen.

Am't of estimate \$.....

Am't Paid \$.....

..... Owner

**Sketch of Service Here** **11**

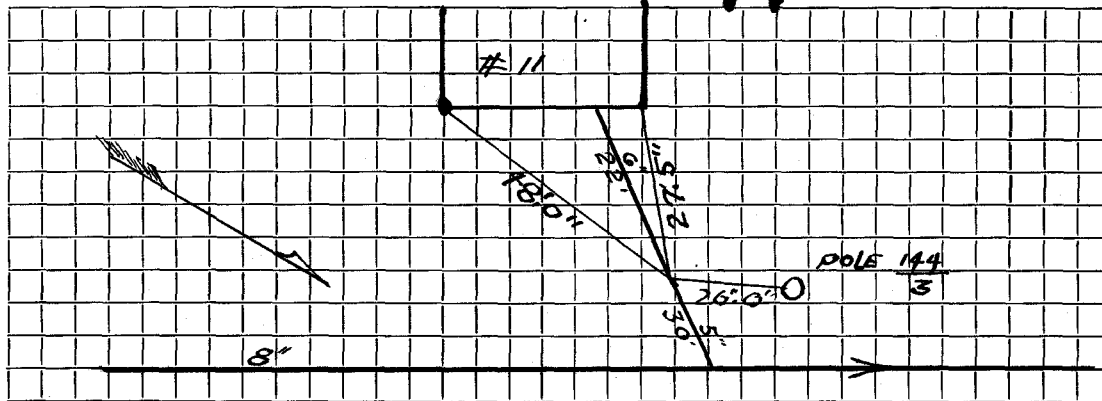

Connection made in..... Street.

Work completed.....19..

Remarks: