

Name

Service No.

Address 15 Preston Rd.

15 Preston Rd.

Location

Kind of Pipe

Size 6"

Size of Main 8"

~~Repair~~ ~~Renewal~~—New Service SEWER SERVICE TO CURB—TO BE CHARGED
WHEN CONNECTED

Location

Date	Material	Amount	Total	Date	Amount
	Outside				
9/11/52	Labor	8 82			
	10% Overhead	88	9 70		
	20' - 5" transitite transitite pipe @.55		11 00		
	2 hr. Brox shovel @10.00		20 00		
	1 hr. trucking		75		
4-12-56	Inside		41 45		
	22' 6" Sewer Pipe				
	Labor				

TOWN OF LEXINGTON—DEPT. OF PUBLIC WORKS

SEWER DIVISION

DATE.....

NO.


The undersigned applies for the construction of a particular sewer connecting No..... Street and hereby agrees to comply with the Rules and Regulations governing the construction and use of Particular Sewers, as now or at any future time established by the Board of Selectmen.

Am't of estimate \$.....

Am't Paid \$.....

..... Owner

Sketch of Service Here **15**

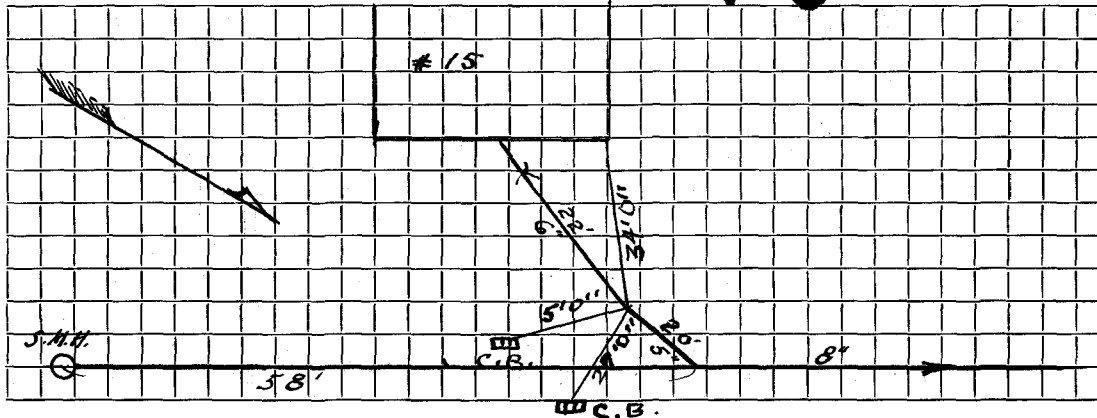

Connection made in..... Street.

Work completed.....19..

Remarks: