

Name Harry E. Petschek

Service No. 21

Address 17 Preston Rd.

17 Preston Road

Location

Kind of Pipe *Wc# 7833*

Size 6"

Size of Main 8"

~~Repair or Renewal~~ New Service SEWER SERVICE TO CURB

Location *Comm 6-3-63*

Date	Material	Amount	Total	Date		Amount
9/11/52	Labor	8 82		4-10-63	Deposit	550 00
	10% Overhead	88	9 70	6-3-63	Refund	82 27
	20' - 5" <del>transite</del> transite pipe @.55		11 00			467 73
	2 hrs. Brox shovel		20 00			
	1 hr. trucking		75			
4-24-63	Labor 79.56		41 45			
4-25-63	" 79.56					
4-29-63	" 53.62	212.74				
	10% O.H.	21.27	234.01			
	150' 6" Transite pipe @.82		123.00			
	1 11 1/2° Transite Bend		4.09			
	1 6 x 6 Tee		4.09			
	1 90° <del>elbow</del> Transite Elbow		4.09			
	9 hr. Trucking @3.00		27.00			
	10 yds. Loam @3.00		30.00			
			467.73			

# TOWN OF LEXINGTON—DEPT. OF PUBLIC WORKS

## SEWER DIVISION

DATE.....

NO. ....

The undersigned applies for the construction of a particular sewer connecting No.....  
 Street and hereby agrees to comply with the Rules and Regulations governing the construction and use of Particular  
 Sewers, as now or at any future time established by the Board of Selectmen.


Am't of estimate \$.....

Am't Paid \$.....

..... Owner

Sketch of Service Here

17

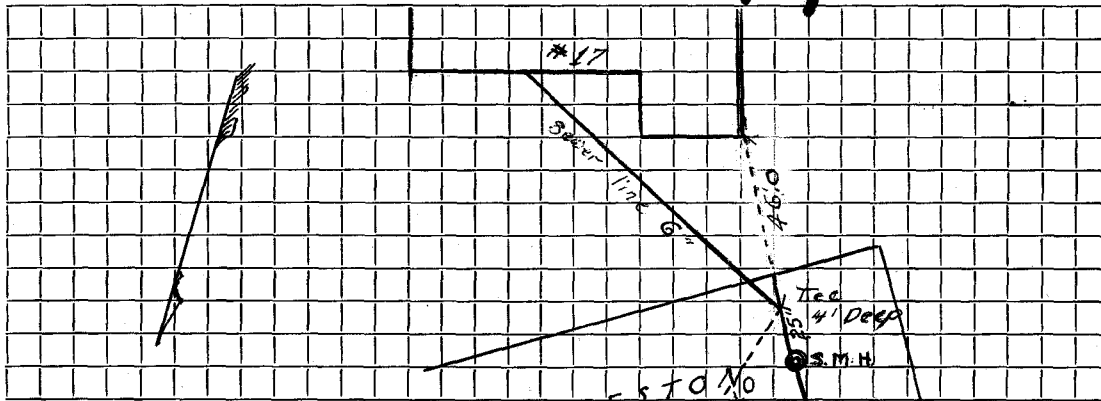

Connection made in.....  
 Street. pole  $\phi$   $\frac{5}{4}$  Work completed.....19..

Remarks:

