

Name 18 Preston Road

Service No.

Address Block 26 - lots 32 - 33 - 34

Location

Kind of Pipe

Size 6"

Size of Main 8"

~~Repair - Renewal~~ - New Service SEWER SERVICE TO CURB - TO BE CHARGED

Location

WHEN CONNECTED

Date	Material	Amount	Total	Date	Amount
	Outside				
9/11/52	Labor	20 58			
	10% Overhead	2 06	22 64		
	20' - 5" transite trench pipe @ .55		11 00		
	4 2/3 hr. Brox Shovel @ 10.00		46 67		
	1 hr. trucking		75		
5-10-55	Inside		81 06		
	32' 6" Sewer Pipe				
	Labor				

TOWN OF LEXINGTON—DEPT. OF PUBLIC WORKS

SEWER DIVISION

DATE.....

NO.

The undersigned applies for the construction of a particular sewer connecting No.....
 Street and hereby agrees to comply with the Rules and Regulations governing the construction and use of Particular
 Sewers, as now or at any future time established by the Board of Selectmen.


Am't of estimate \$.....

Am't Paid \$.....

..... Owner

Sketch of Service Here

18

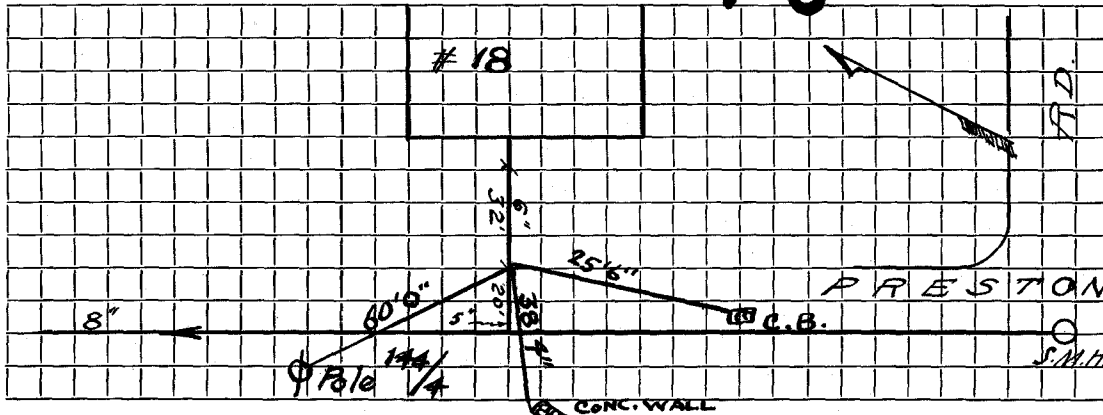

Connection made in..... Street.

Work completed.....19..

Remarks: