

Name David-H. Evans

Service No. 1095

Address 3 Preston Road

Lexington, Mass.

Location 3 Preston Road

Kind of Pipe

Size 6"

Size of Main 8"

Repair - Renewal - New Service

Location

Date	Material	Amount	Total	Date	Amount
Oct. 24, '47	Labor	35 10	35 10	Oct 14 '47	125 00
	10% Overhead		3 51	Nov 29 '47	38 95
	68' - 6" Sewer Pipe @.26		17 68		91 05
	1 O 6" Elbow		1 18		
	Joint Compound		4 08		
	Hired Shovel 4 hrs. @ 7.00		28 00		
	Trucking 2 hrs. @ .75		1 50		
			38 05		
	Labor				
	Com 11-24-47				

TOWN OF LEXINGTON—DEPT. OF PUBLIC WORKS

SEWER DIVISION

DATE

NO.


The undersigned applies for the construction of a particular sewer connecting No. Street and hereby agrees to comply with the Rules and Regulations governing the construction and use of Particular Sewers, as now or at any future time established by the Board of Selectmen.

Am't of estimate \$.....

Am't Paid \$.....

..... Owner

Sketch of Service Here **3**

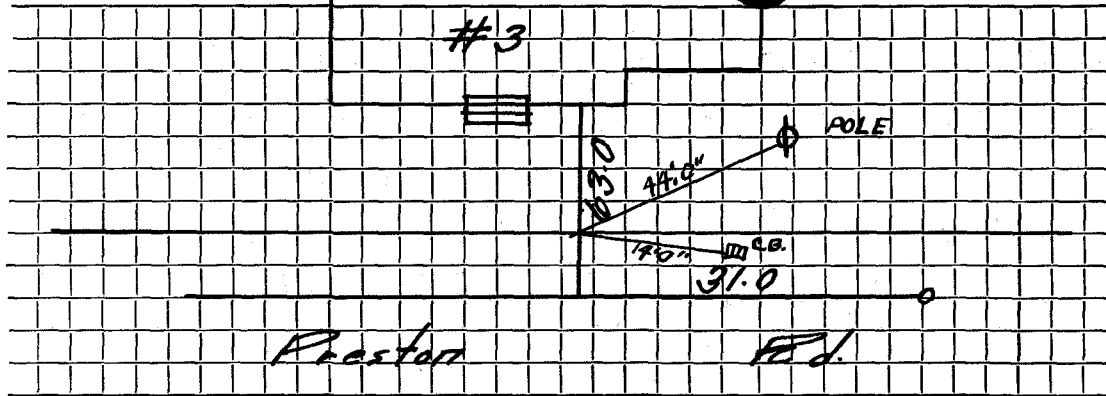

Connection made in Street.

Work completed 19..

Remarks: