




DATE \_\_\_\_\_

TOWN OF LEXINGTON — BOARD OF PUBLIC WORKS  
SEWER DIVISION

Sketch of Service Here

7

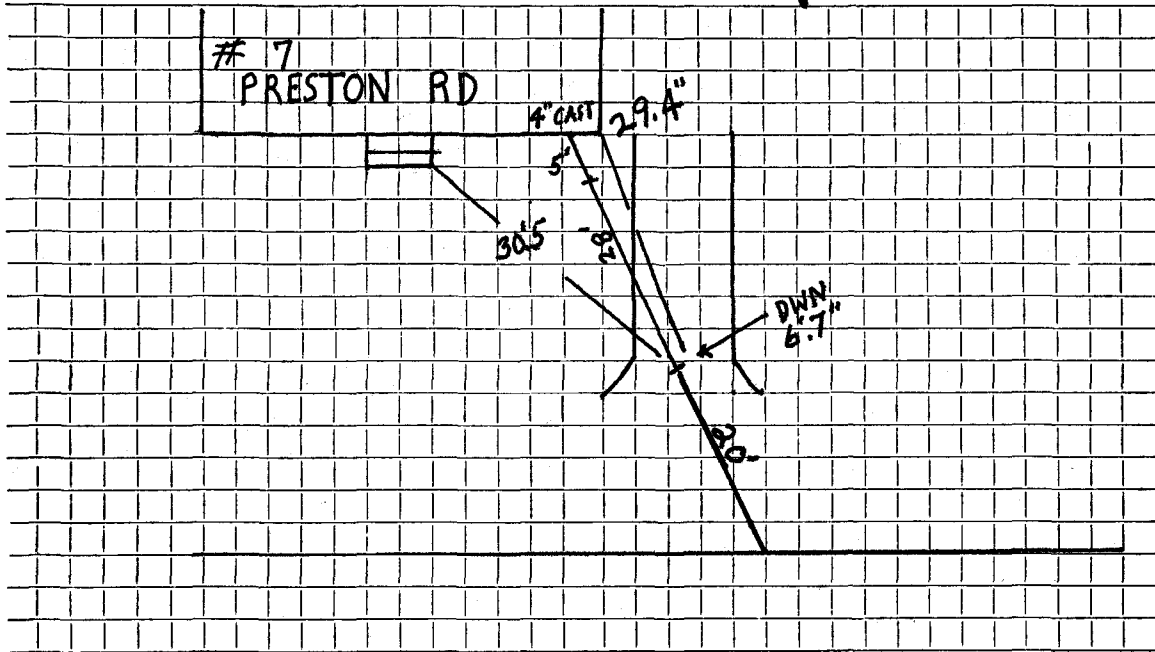

Connection made in ..... Street. Work completed .....

Remarks: ORIGINAL SERVICE PUT IN MARCH, 16, 1949... NOV. 9, 3. TOWN RENEWD. OUTSIDE.....

.....  
.....