


DATE 7/14/22

TOWN OF LEXINGTON — BOARD OF PUBLIC WORKS
SEWER DIVISION

Sketch of Service Here

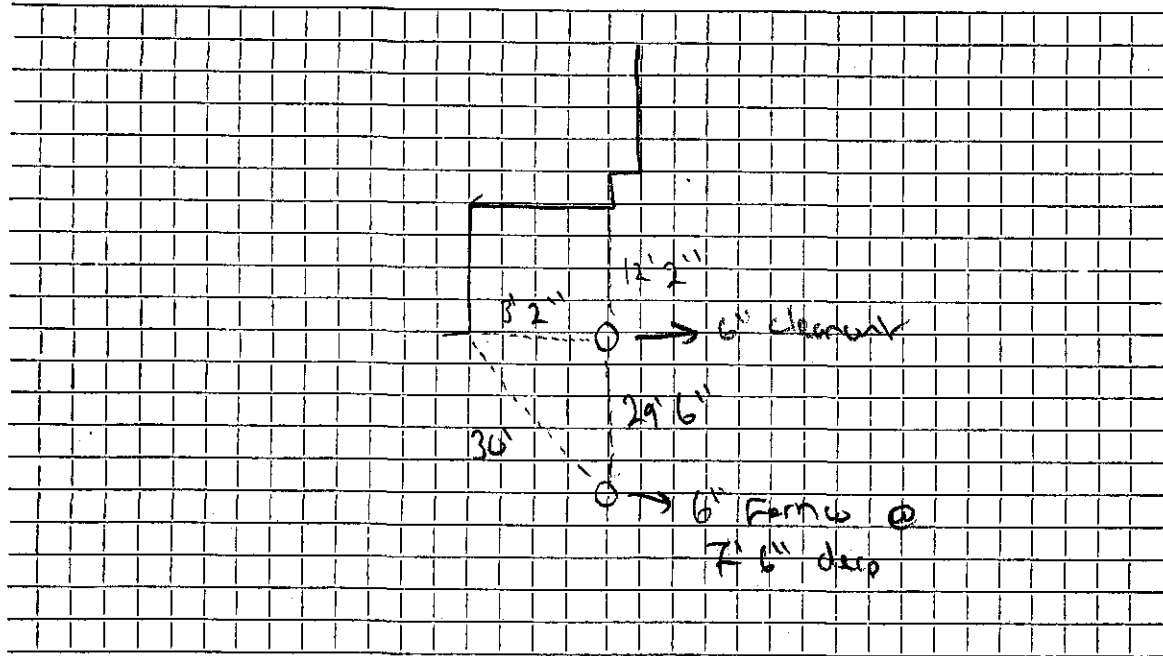

Connection made in Street. Work completed

Remarks: INSTALLED BY MCLAUGHLIN