

Name J. H. Wellington

Service No. 157

Address 21 Prospect Hill Road

Lexington, Mass.

Location

Kind of Pipe

Size 6"

Size of Main 8"

~~Repair~~ New Service

Com. 11-13-51

Location

Date	Material	Amount	Total	Date	Amount
10/22/51	Labor	31 66	31 66	10-11-51	Deposited 200 -
	10% overhead		3 17	11-13-51	Refunded 10.6 93
	32' -6" sewer pipe @ .342		10 94		93 07
	1 - 6" elbow		1 88		
	joint compound		1 92		
	6 hrs. Littlefield shovel @ \$7.		42 00		
	2 hrs. trucking @ .75		1 50		
			93 07		
				4.4.05	Repair made in sidewalk area
					4'-6" PVC
	Labor				2- 6x6 PVC to Clay Franco
					1- 6" - 22° Bend

TOWN OF LEXINGTON—DEPT. OF PUBLIC WORKS
SEWER DIVISION

DATE

NO.


The undersigned applies for the construction of a particular sewer connecting No.
Street and hereby agrees to comply with the Rules and Regulations governing the construction and use of Particular
Sewers, as now or at any future time established by the Board of Selectmen.

Am't of estimate \$.....

Am't Paid \$.....

..... Owner

Sketch of Service Here

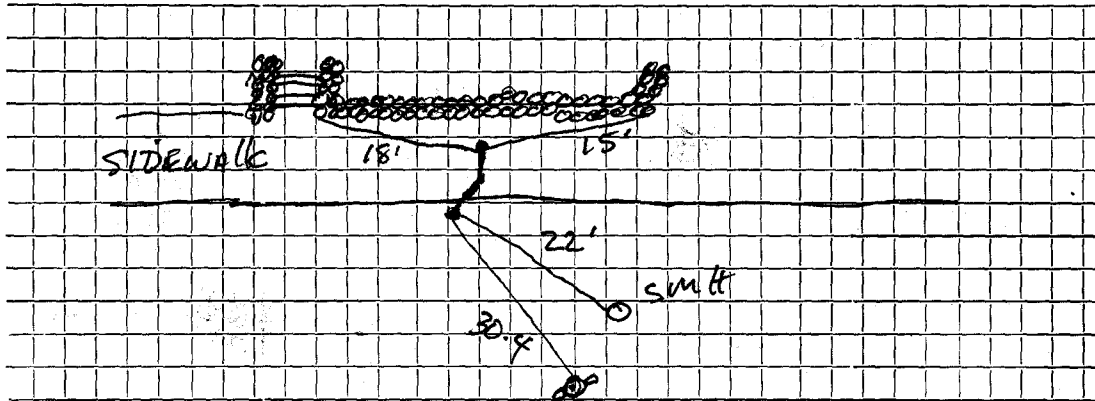

Connection made in Street.

Work completed 19..

Remarks:

repair made in sidewalk. service
is only 84 deep under sidewalk
DIVERG AS SHOWN AS IT GOES INTO STREET