

R. 3782

Name Mrs. I. N. Swenson

Service No. 28

Address 39 Prospect Hill Rd.

Lexington

Location

Kind of Pipe

Size 6"

Size of Main 8"

~~Repair or Renewal~~ New Service

COM. 6-16-52

Location

Date	Material	Amount	Total	Date	Amount
4/16/52	Labor	37 01		4-4-52	150 00
	10% overhead	3 70	40 71	6-16-52	37 83
	40' - 6" sewer pipe @ .342		13 68		112 17
	1 - 6" elbow		1 88		
	joint compound		2 40		
	6 hrs. Littlefield shovel		42 00		
	2 hrs. trucking		1 50		
	patching 10 x 3		10 00		
			<u>112 17</u>		
	Labor				

TOWN OF LEXINGTON—DEPT. OF PUBLIC WORKS.

SEWER DIVISION

DATE.....

NO.


The undersigned applies for the construction of a particular sewer connecting No.....
Street and hereby agrees to comply with the Rules and Regulations governing the construction and use of Particular
Sewers, as now or at any future time established by the Board of Selectmen.

Am't of estimate \$.....

Am't Paid \$.....

..... Owner

Sketch of Service Here

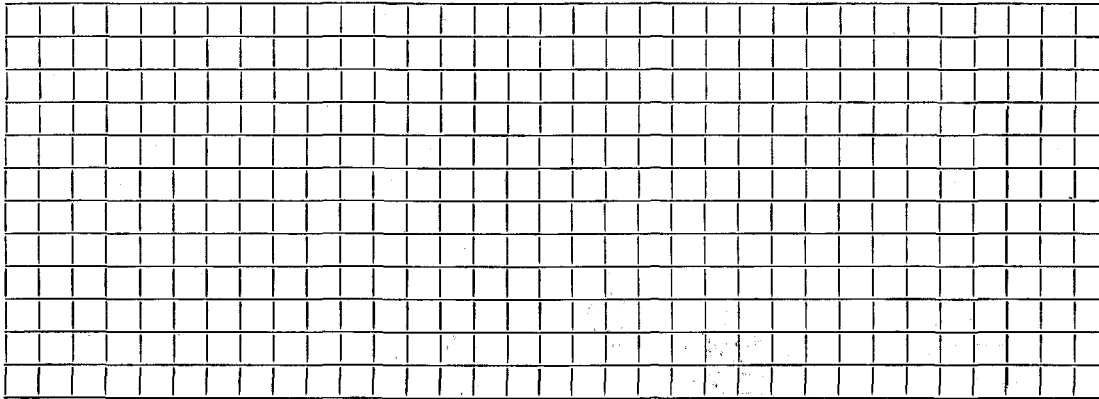

Connection made in Street.

Work completed.....19..

Remarks: