


DATE 7-30-91

TOWN OF LEXINGTON — BOARD OF PUBLIC WORKS
SEWER DIVISION

Sketch of Service Here

44 PROSPECT HILL

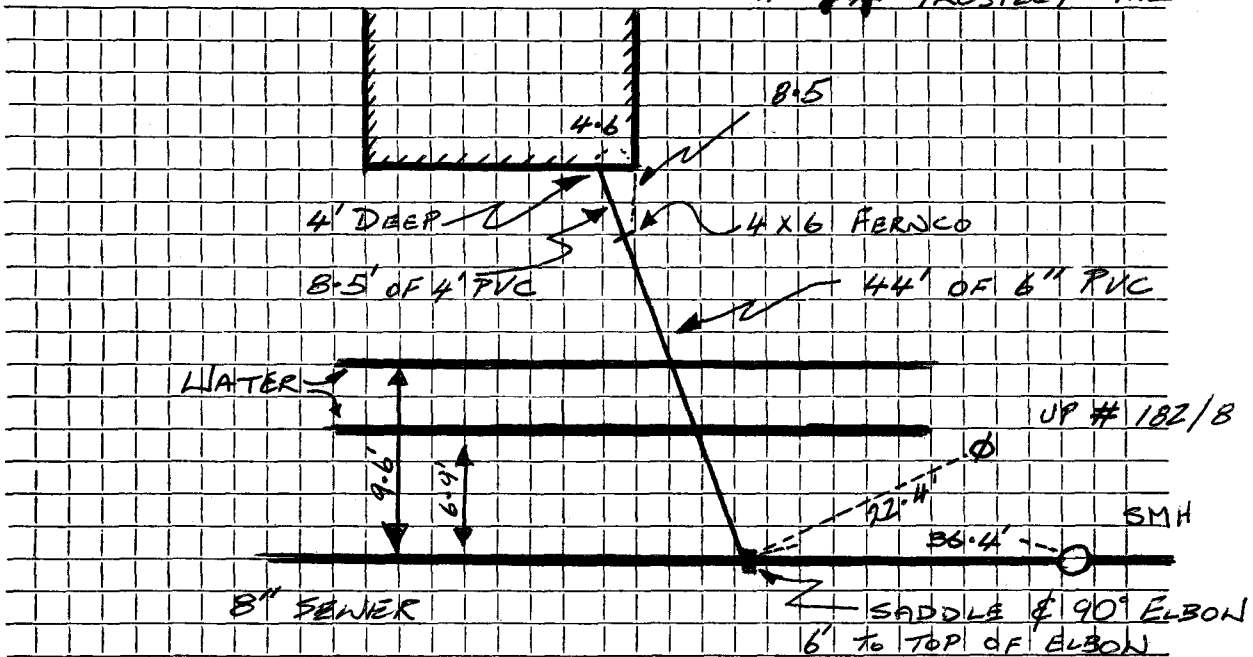

Connection made in #44 Prospect Hill Street. Work completed 7-30-91

Remarks: BASEMENT SERVED BY SEWER

CONTRACTOR : B. MCKEE

INSPECTOR : SAM