

Name **Mr. Kenworthy**

Service No. **134**

Address **61 Prospect Hill Rd.**

Lexington, Mass.

Location

Kind of Pipe

Size **6"**

Size of Main **8"**

~~REPLACEMENT~~ **New Service**

Com. 11-13-51

Location

Date	Material	Amount	Total	Date	Amount
10/16/51	labor	65 66	65 66	9-28-51	Deposited 175 00
10/18/51	"	16 64	16 64	11-13-51	Refunded 13 09
	10% overhead		8 23		161 91
	88' - 6" sewer pipe @ .342		30 10		
	joint compound		5 28		
	6 hrs. Town shovel @ 5.00		30 00		
	2 hrs. trucking @ 3.00		6 00		
			<u>161 91</u>		
	Labor				

TOWN OF LEXINGTON—DEPT. OF PUBLIC WORKS
SEWER DIVISION

DATE

NO.


The undersigned applies for the construction of a particular sewer connecting No.
Street and hereby agrees to comply with the Rules and Regulations governing the construction and use of Particular
Sewers, as now or at any future time established by the Board of Selectmen.

Am't of estimate \$.

Am't Paid \$.

..... Owner

Sketch of Service Here

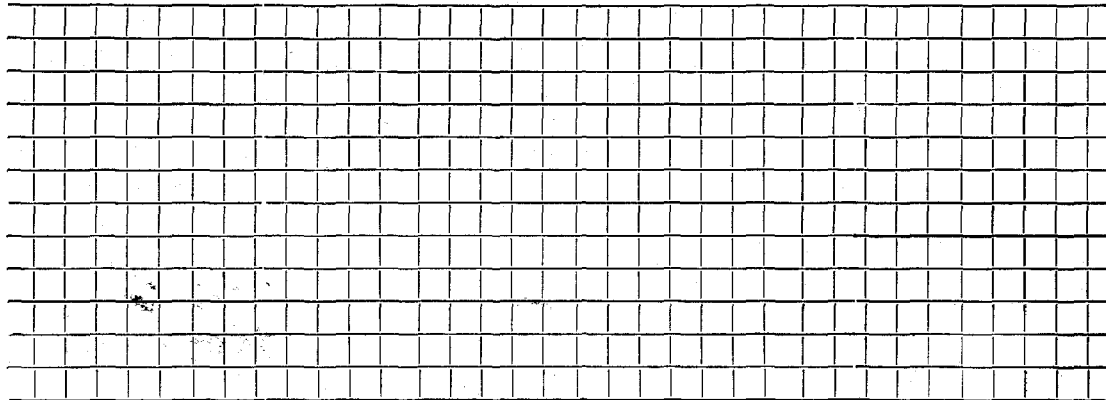

Connection made in Street.

Work completed 19..

Remarks: