

Name JOHN F. SOLAN, JR.

Service No. 115

Address 65 Prospect Hill Road

65 Prospect Hill Road

Location

Kind of Pipe

Size 6"

Size of Main 8"

~~Repair~~ ~~Renewal~~ ~~New Service~~

W. O. # 8291

Location APR 26 1972

Date	Material	Amount	Total	Date	Amount
11/29/71	Labor	55 53		11-17-71	400 00
11/30/71	"	37 02			
12/21	"	18 51	111 06	4-24-72	149.33
	10% O.H.		11 11		
					OUTSIDE
50'	6" Transite pipe .90		45 00	11/29/71	96 90
1	Donut		2 65	11/30/71	47 69
				12/10/71	20 05
				20'	Transite pipe .90
1	1 1/2" El		3 95	1	18 00
1	2'x6" Nipple		2 90	1	1'x6" Nipple
1				1	6"x6" "
4	Yds. Loam 3.50		14 00	1	90o El
10	Lbs. Seed 1.10		11 00	1	7 45
1	Hr. Trucking		3 00	1	Yd. Loam
4	Hrs. Shovel 6.50		26 00	2	Lbs. Seed 1.10
			230 67	2 1/2	Hrs. Trucking 3.00
				1 1/2	" Shovel 4.00
				1	" Compressor
				1	" Loader
				1	" Roller
					Trailer
					2 00
					2 00
					227 93
				12-21-66	Roots
				64'	Roots


DATE _____

TOWN OF LEXINGTON — BOARD OF PUBLIC WORKS

SEWER DIVISION

Sketch of Service Here

65

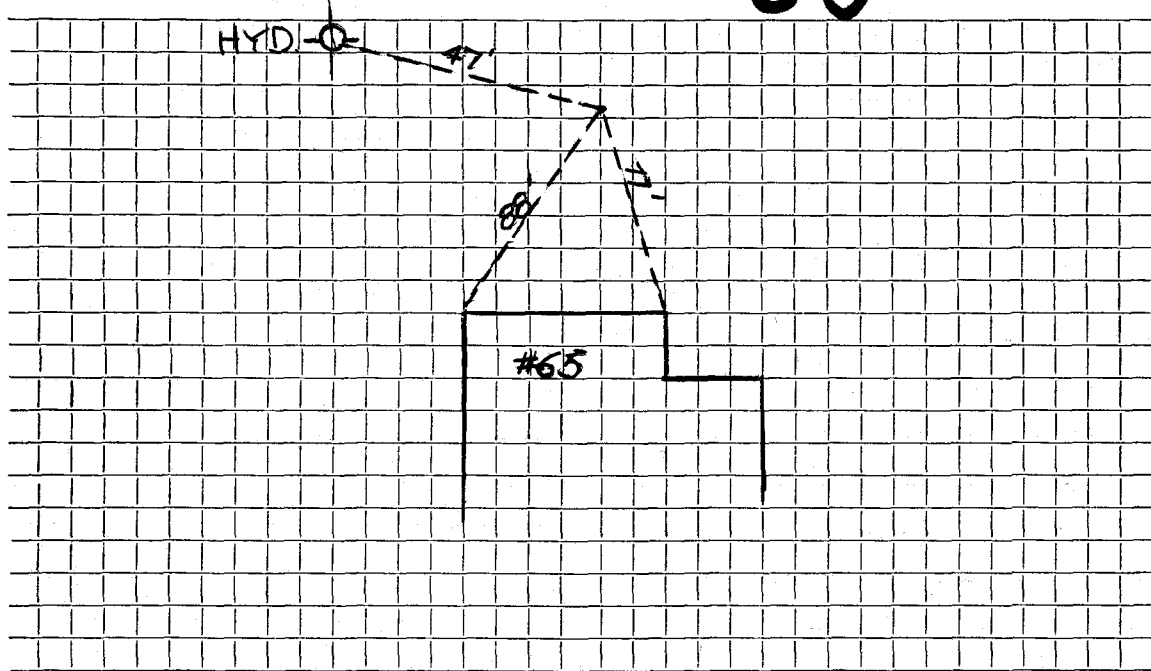

Connection made in Street.

Work completed

Remarks: Original Service 10-29-51 (72'-6" Sewer Pipe, 1-6" Elbow)

.....
.....