


Date: 2/15/24

TOWN OF LEXINGTON - BOARD OF PUBLIC WORKS  
SEWER DIVISION

SKETCH OF SERVICE HERE  
72 Prospect Hill Rd

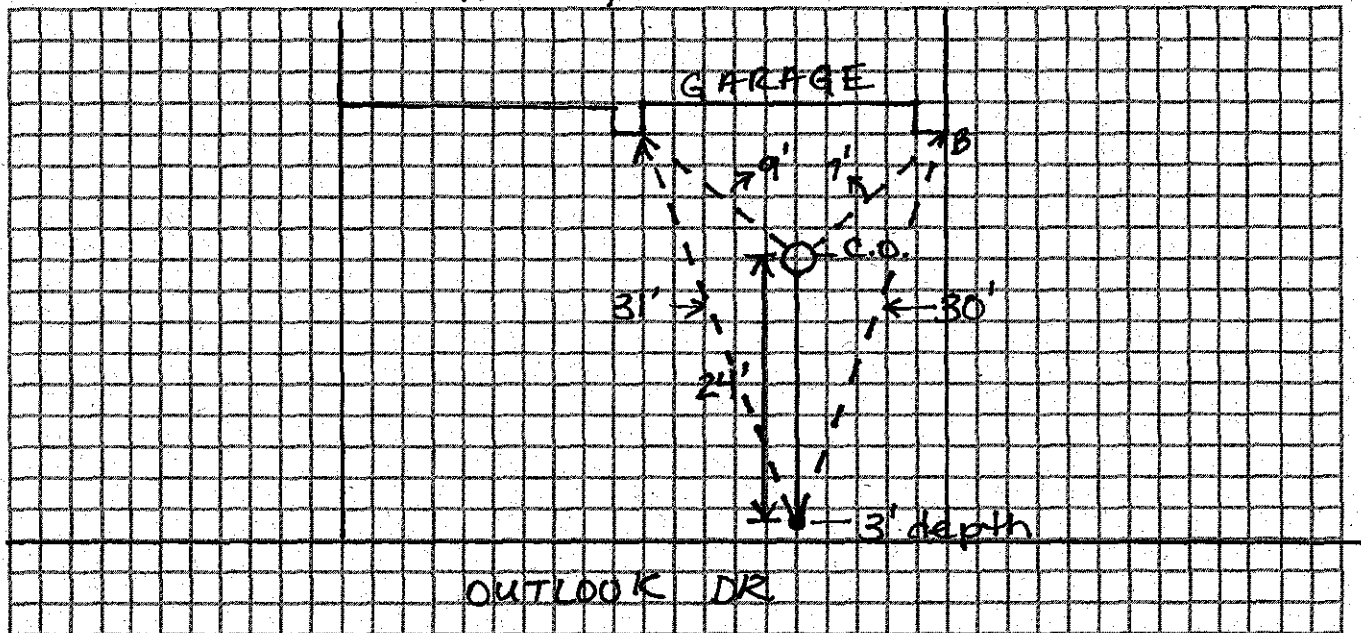

Connection made in: \_\_\_\_\_ Street: \_\_\_\_\_ Work completed: \_\_\_\_\_  
Remarks: Installed by D.J. Morris

