

Name **Mr. Flora E. Gray**

Service No. **7**

Address **118 Radcliffe Street, Dorchester.**

Location **10-12 Locust Avenue**

Kind of Pipe

Size

Size of Main

Repair—Renewal—New Service

Location

Date	Material	Amount	Total	Date	Amount
May 22, 1940	17 hrs. @ 55¢	9 35		May 18, 1940 Deposited	95 00
Jan 11/40	75 " @ 60¢	45 00		June 11, 1940 Refunded	44
	9½ " @ 70¢	6 65	61 00		94 56
	10% Overhead		6 10		
	40' 6" Sewer pipe @ 16¢		6 40		
	Jointing compound		2 40		
	Compressor, 1 hr. @ 3.00		3 00		
	Trucking, 4 hrs. @ 75¢		3 00		
	Trench repairs		12 66		
			94 56		
	Labor				

Hadley Press, Inc., Lexington

TOWN OF LEXINGTON - BOARD OF PUBLIC WORKS  
SEWER DIVISION

DATE \_\_\_\_\_


NO. \_\_\_\_\_

The undersigned applies for the construction of a particular sewer connecting No. \_\_\_\_\_  
Street and hereby agrees to comply with the Rules and Regulations governing the construction and use of Particular  
Sewers, as now or at any future time established by the Board of Selectmen.

Am't. of Estimate \$ \_\_\_\_\_

Am't. Paid \$ \_\_\_\_\_

Owner \_\_\_\_\_

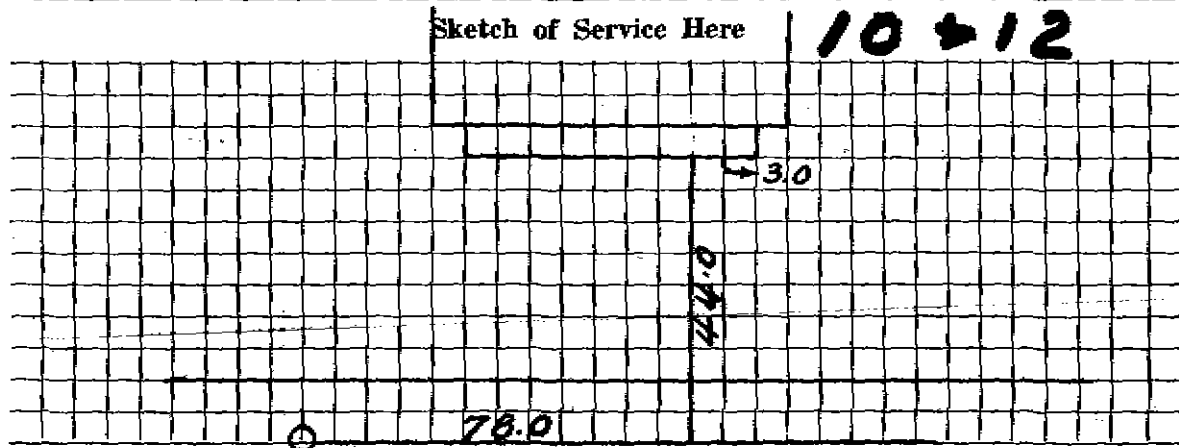

Connection made in \_\_\_\_\_ Street.

Work completed \_\_\_\_\_ 19

Remarks: