


DATE _____

TOWN OF LEXINGTON — BOARD OF PUBLIC WORKS
SEWER DIVISION

Sketch of Service Here **12**

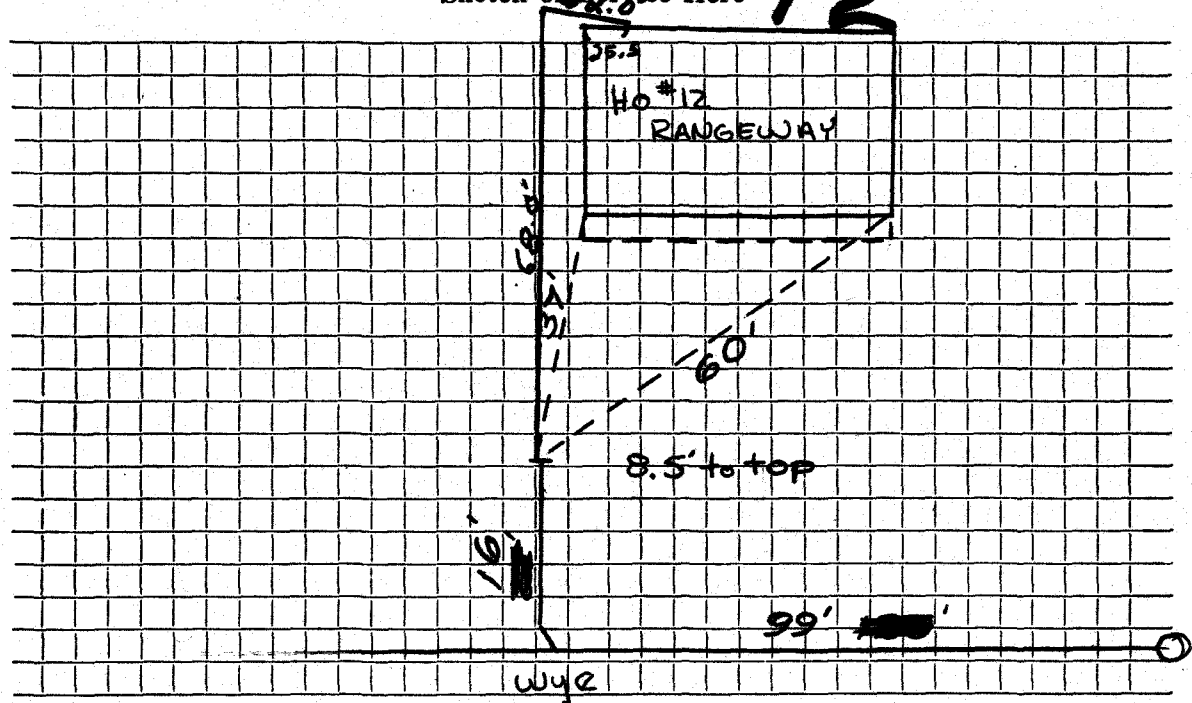

Connection made in **#12 RANGEWAY**..... Street. Work completed **10/16/75**.....

Remarks:

.....

.....